


1 LOCATION OF WATER WELL:	Fraction	Section Number	Township Number	Range Number
County: <b>Saline</b>	<b>NW 1/4 NW 1/4 SW 1/4</b>	<b>35</b>	<b>16</b>	<b>4 W</b>

Distance and direction from nearest town or city street address of well if located within city?  
**2 1/2 Miles North & 3 miles West of Lindsborg, KS**

2 WATER WELL OWNER: <b>Mike Hoag</b>	Board of Agriculture, Division of Water Resources
RR#, St. Address, Box #: <b>927 N. Main</b>	Application Number: <b>N/A</b>
City, State, ZIP Code : <b>Lindsborg, KS 67456</b>	

3 MARK WELL'S LOCATION WITH AN "X" IN SECTION BOX: N	4 DEPTH OF WELL... <b>165-165-165-165</b> ft. <b>4 @ 165 ea.</b> WELL'S STATIC WATER LEVEL..... <b>10</b> ft. WELL WAS USED AS: <div style="display: flex; justify-content: space-between;"> <div> 1 Domestic 2 Irrigation 3 Feedlot 4 Industrial </div> <div> 5 Public Water Supply 6 Oil Field Water Supply 7 Lawn and Garden Only 8 Air Conditioning </div> <div> 9 Dewatering 10 Monitoring Well 11 Injection Well <b>12 Other....Heat..Pump</b> </div> </div>
---	--

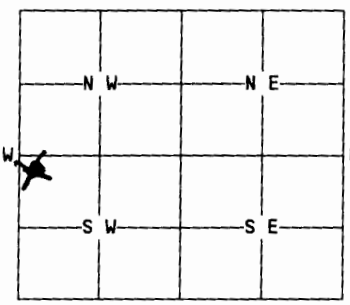

Was a chemical/bacteriological sample submitted to Department? Yes....No..**X**.  
 If yes, mo/day/yr sample was submitted.....

Water Well Disinfected: Yes..**X**.. No.....

5 TYPE OF BLANK CASING USED:	Blank casing diameter... <b>3/4</b> ...in. Was casing pulled? Yes..... No..... If yes, how much.....
1 Steel    3 RMP (SR)    5 Wrought    7 Fiberglass <b>X Other (specify below)</b> 2 PVC    4 ABS    6 Asbestos-Cement    8 Concrete Tile    ..... <b>Polyethylene</b> .....	
Casing height above or below land surface.....in.	

6 GROUT PLUG MATERIAL: 1 Neat cement    2 Cement grout <b>X Bentonite</b> 4 Other.....	Grout Plug Intervals: From.. <b>0</b> ...ft. to.. <b>165</b> ft., From.. <b>0</b> ...ft. to.. <b>165</b> ft., From.. <b>0</b> to.. <b>165</b> ft.
What is the nearest source of possible contamination:	
1 Septic tank    6 Seepage pit    11 Fuel storage    16 Other (specify below) 2 Sewer lines    7 Pit privy    12 Fertilizer storage 3 Watertight sewer lines <b>X Sewage lagoon</b> 13 Insecticide storage 4 Lateral lines    9 Feedyard    14 Abandoned water well 5 Cess Pool    10 Livestock pens    15 Oil well/Gas well	
Direction from well? ... <b>North</b> ..... How many feet? ... <b>200</b> .....	

FROM	TO	PLUGGING MATERIALS
0	4	Topsoil
4	38	Red & Green Shale
38	70	Red & Gray Shale
70	85	Gray Shale
85	86	Limestone
86	95	Gray Shale
95	95.5	Small Cavity

95.5    170    **Gray Shale with Gypsum**

7 CONTRACTOR'S OR LANDOWNER'S CERTIFICATION: This water well was plugged under my jurisdiction and was completed on (mo/day/year).... <b>10/19/00</b> .... and this record is true to the best of my knowledge and belief. Kansas Water Well Contractor's License No. ... <b>138</b> ..... This Water Well Record was completed on (mo/day/year) .. <b>10/24/00</b> .....	by (signature) .. <i>Mike Peterson</i> .....
---	--

INSTRUCTIONS: Use typewriter or ball point pen. Please press firmly and print clearly. Please fill in blanks, underline or circle the correct answers. Send top three copies to Kansas Department of Health and Environment, Bureau of Water, Topeka, Kansas 66620-0001. Telephone: 785/296-3565. Send one to Water Well Owner and retain one for your records.