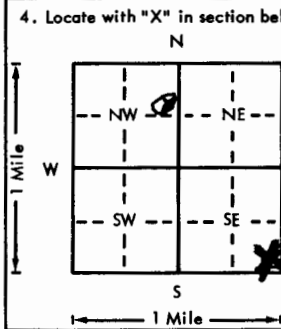


USE TYPEWRITER OR BALL
POINT PEN-PRESS FIRMLY,
PRINT CLEARLY.

WATER WELL RECORD
KSA 82a-1201-1215

Kansas Department of Health and
Environment-Division of Environment
(Water well Contractors)
Topeka, Kansas 66620

1. Location of well:		County <u>Saline</u>	Fraction <u>SE 1/4 SE 1/4 SE 1/4</u>	Section number <u>17</u>	Township number <u>T 16 S R 4 E</u>	Range number <u>4</u>
2. Distance and direction from nearest town or city: <u>1 W - 15.8</u> <u>Falun Kansas.</u>		3. Owner of well: <u>Charles Kelley</u> R.R. or street: <u>P.R.I.</u> City, state, zip code: <u>Falun Kansas 67442</u>				
4. Locate with "X" in section below:		Sketch map:		6. Bore hole dia. <u>8</u> in. Completion date <u>11-14-75</u> Well depth <u>105</u> ft.		
				7. <input checked="" type="checkbox"/> Cable tool <input checked="" type="checkbox"/> Rotary <input type="checkbox"/> Driven <input type="checkbox"/> Dug <input type="checkbox"/> Hollow rod <input type="checkbox"/> Jetted <input type="checkbox"/> Bored <input type="checkbox"/> Reverse rotary		
5. Type and color of material		From		To		8. Use: <input type="checkbox"/> Domestic <input type="checkbox"/> Public supply <input type="checkbox"/> Industry <input type="checkbox"/> Irrigation <input type="checkbox"/> Air conditioning <input checked="" type="checkbox"/> Stock <input type="checkbox"/> Lawn <input type="checkbox"/> Oil field water <input type="checkbox"/> Other
<u>Top Soil</u>		<u>0</u>		<u>2</u>		9. Casing: Material <u>PVC</u> Height: <u>Above or below</u> Threaded <input type="checkbox"/> Welded <input checked="" type="checkbox"/> Surface <u>34</u> in. RMP <input type="checkbox"/> PVC <input checked="" type="checkbox"/> Weight <u>14</u> lbs./ft. Dia. <u>4</u> in. to <u>4</u> ft. depth Wall Thickness: inches or Dia. <u>4</u> in. to <u>4</u> ft. depth gage No. <u>14</u>
<u>Sandy clay - sandstone gravel & pebbles</u>		<u>2</u>		<u>9</u>		10. Screen: Manufacturer's name <u>Paterson</u> <u>Paterson</u> Type <u>PVC</u> Dia. <u>5</u> in. Slot/gauze <u>1/16</u> Length <u>30</u> ft. Set between <u>105</u> ft. and <u>95</u> ft. <u>50</u> ft. and <u>60</u> ft. Gravel pack? <u>yes</u> Size range of material <u>4-16</u>
<u>Traces of Charcoal</u>		<u>9</u>		<u>105</u>		11. Static water level: <u>25</u> ft. below land surface Date <u>11-14-75</u> mo./day/yr.
<u>Layers Red & Vary hard Blue</u>						12. Pumping level below land surfaces: <u>100</u> ft. after <u>3</u> hrs. pumping <u>7-1</u> g.p.m. <u> </u> ft. after <u> </u> hrs. pumping <u> </u> g.p.m. Estimated maximum yield <u>1</u> g.p.m.
<u>Shales.</u>						13. Water sample submitted: <u> </u> mo./day/yr. Yes <input checked="" type="checkbox"/> No <input type="checkbox"/> Date <u> </u>
<u>Water Bearing layer 54-55 feet.</u>						14. Well head completion: <u> </u> Pitless adapter <u>24</u> inches above grade
						15. Well grouted? <u>yes</u> With: <input checked="" type="checkbox"/> Neat cement <input type="checkbox"/> Bentonite <input type="checkbox"/> Concrete Depth: From <u>0</u> ft. to <u>15</u> ft.
						16. Nearest source of possible contamination: <u>Pasture</u> ft. <u>none</u> Direction <u> </u> Type <u> </u> Well disinfected upon completion? <input checked="" type="checkbox"/> Yes <input type="checkbox"/> No
						17. Pump: <input checked="" type="checkbox"/> Not installed Manufacturer's name <u> </u> Model number <u> </u> HP <u> </u> Volts <u> </u> Length of drop pipe <u> </u> ft. capacity <u> </u> g.p.m. Type: <input type="checkbox"/> Submersible <input type="checkbox"/> Turbine <input type="checkbox"/> Jet <input type="checkbox"/> Reciprocating <input type="checkbox"/> Centrifugal <input type="checkbox"/> Other
						20. Water well contractor's certification: This well was drilled under my jurisdiction and this report is true to the best of my knowledge and belief. <u>Peterson Bros Inc</u> <u>138</u> Business name License No. Address <u>Box 150 Lindalby Kans</u> Signed <u>Wally Peterson</u> Date <u>11-14-75</u> By <u>NP</u> Authorized representative
18. Elevation:		19. Remarks:				
Topography: <input checked="" type="checkbox"/> Hill <input type="checkbox"/> Slope <input type="checkbox"/> Upland <input type="checkbox"/> Valley		<u>open Pasture for 18 acw.</u> <u>Located on side of hill.</u> <u>Customer knows about the law.</u> <u>will pour concrete slab.</u>				

Forward the white, blue and pink copies to the Department of Health and Environment

Form WWC-5