


1 LOCATION OF WATER WELL: County: Greeley	Fraction SW ¼ NW ¼ NE ¼	Section Number 20	Township Number T 16 S	Range Number R 40 E/VX
--	----------------------------	----------------------	---------------------------	---------------------------

Distance and direction from nearest town or city street address of well if located within city?  
 x 13 miles north of tribune

2 WATER WELL OWNER: Ox Town Cattle Feeders Inc.  
 RR#, St. Address, Box #: Box 428  
 City, State, ZIP Code: Tribune KS 67879  
 Board of Agriculture, Division of Water Resources  
 Application Number: 36139

3 LOCATE WELL'S LOCATION WITH AN "X" IN SECTION BOX:

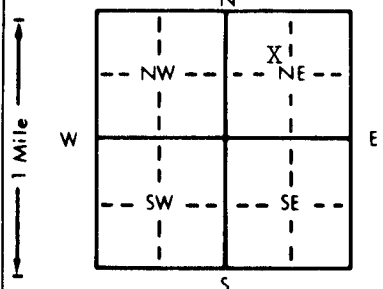

4 DEPTH OF COMPLETED WELL: 224 ft. ELEVATION: 3650  
 Depth(s) Groundwater Encountered 1. 180 ft. 2. ft. 3. ft.  
 WELL'S STATIC WATER LEVEL 180 ft. below land surface measured on mo/day/yr 5-15-97

Pump test data: Well water was 220 ft. after 3 hours pumping 100 gpm  
 Est. Yield 100 gpm; Well water was ft. after hours pumping gpm  
 Bore Hole Diameter 26 in. to ft., and in. to ft.  
 WELL WATER TO BE USED AS:  
 1 Domestic 3 Feedlot 6 Oil field water supply 9 Dewatering 12 Other (Specify below)  
 2 Irrigation 4 Industrial 7 Lawn and garden only 10 Monitoring well  
 Was a chemical/bacteriological sample submitted to Department? Yes No X; If yes, mo/day/yr sample was submitted  
 Water Well Disinfected? Yes X No

5 TYPE OF BLANK CASING USED:  
 1 Steel 3 RMP (SR) 5 Wrought iron 8 Concrete tile CASING JOINTS: Glued X Clamped  
 2 PVC 4 ABS 6 Asbestos-Cement 9 Other (specify below) Welded  
 7 Fiberglass Threaded

Blank casing diameter x 12 in. to 184 ft. Dia in. to ft. Dia in. to ft.  
 Casing height above land surface 12 in. weight lbs./ft. Wall thickness or gauge No. X SCH 40

TYPE OF SCREEN OR PERFORATION MATERIAL:  
 1 Steel 3 Stainless steel 5 Fiberglass 7 PVC 10 Asbestos-cement  
 2 Brass 4 Galvanized steel 6 Concrete tile 8 RMP (SR) 11 Other (specify)  
 9 ABS 12 None used (open hole)

SCREEN OR PERFORATION OPENINGS ARE:  
 1 Continuous slot 3 Mill slot 5 Gauzed wrapped 8 Saw cut 11 None (open hole)  
 2 Louvered shutter 4 Key punched 6 Wire wrapped 9 Drilled holes  
 7 Torch cut 10 Other (specify)

SCREEN-PERFORATED INTERVALS: From 184 ft. to 224 ft. From ft. to ft.  
 GRAVEL PACK INTERVALS: From 224 ft. to 30 ft. From ft. to ft.

6 GROUT MATERIAL: 1 Neat cement 2 Cement grout 3 Bentonite 4 Other  
 Grout Intervals: From x 5 ft. to 30 ft. From ft. to ft. From ft. to ft.

What is the nearest source of possible contamination:  
 1 Septic tank 4 Lateral lines 7 Pit privy 10 Livestock pens 14 Abandoned water well  
 2 Sewer lines 5 Cess pool 8 Sewage lagoon 11 Fuel storage 15 Oil well/Gas well  
 3 Watertight sewer lines 6 Seepage pit 9 Feedyard 12 Fertilizer storage 16 Other (specify below)  
 13 Insecticide storage

Direction from well? North East How many feet? 200

FROM	TO	LITHOLOGIC LOG	FROM	TO	PLUGGING INTERVALS
0	10	Topsoil and clay	203	205	Clay
10	21	Fine sand	205	207	Sand fine to medium
21	40	Caliche	207	214	Clay
40	49	Sand med to coarse tight	214	222	Yellow samny clay
49	65	Sand med and little caliche	222	224	Blue shale
65	90	Sand coarse and caliche tight			
90	98	Grey clay			
98	114	Brown sandy clay			
114	132	Brown sandy clay, caliche and fine sand			
132	147	Sand med and little clay tight			
147	164	Sand fine to medium			
164	170	Caliche and cemented sand very hard			
170	180	Sand med to coarse and clay streaks			
180	196	Sand medium loose and clean			
196	203	and fine to medium			

7 CONTRACTOR'S OR LANDOWNER'S CERTIFICATION: This water well was (1) constructed, (2) reconstructed, or (3) plugged under my jurisdiction and was completed on (mo/day/year) 5/19/97 and this record is true to the best of my knowledge and belief. Kansas Water Well Contractor's License No. 473. This Water Well Record was completed on (mo/day/yr) 5/19/97 under the business name of Tyler Water Well Service Inc. by (signature) *Randy Z...*