


USE TYPEWRITER OR BALL POINT PEN-PRESS FIRMLY, PRINT CLEARLY.

WATER WELL RECORD
KSA 82a-1201-1215

Kansas Department of Health and Environment-Division of Environment
(Water well Contractors)
Topeka, Kansas 66620

1. Location of well:	County Greeley	Fraction Center 1/4 SE 1/4	Section number 12	Township number T 16 S	Range number R 40 E/W
----------------------	--------------------------	--------------------------------------	-----------------------------	----------------------------------	---------------------------------

2. Distance and direction from nearest town or city: 14 mi. N.- 4 E.- & 1/4 N. of Tribune, Kans. Street address of well location if in city:	3. Owner of well: Charles Sessler R.R. or street: City, state, zip code: Ellinwood, Kans. 67526
---	---

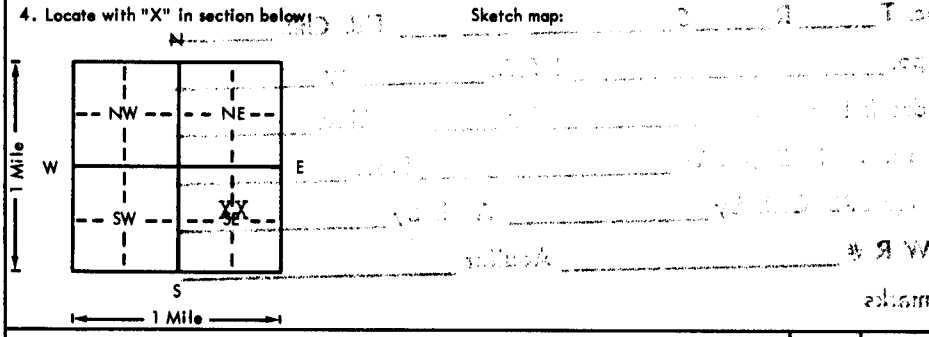

5. Bore hole dia. 28 in. Completion date 6-18-76 Well depth 218 ft.
7. Cable tool <input type="checkbox"/> Rotary <input type="checkbox"/> Driven <input type="checkbox"/> Dug <input type="checkbox"/> <input type="checkbox"/> Hollow rod <input type="checkbox"/> Jetted <input type="checkbox"/> Bored <input checked="" type="checkbox"/> Reverse rotary
8. Use: Domestic <input type="checkbox"/> Public supply <input type="checkbox"/> Industry <input type="checkbox"/> <input checked="" type="checkbox"/> Irrigation <input type="checkbox"/> Air conditioning <input type="checkbox"/> Stock <input type="checkbox"/> <input type="checkbox"/> Lawn <input type="checkbox"/> Oil field water <input type="checkbox"/> Other
9. Casing: Material Steel Height: Above or below XXXX Threaded <input type="checkbox"/> Welded <input checked="" type="checkbox"/> Surface 12 in. BMP <input type="checkbox"/> PVC <input type="checkbox"/> Weight 40 lbs./ft. Dia. 16 in. to 208 ft. depth Wall Thickness: inches or Dia. <input type="checkbox"/> in. to <input type="checkbox"/> ft. depth gage No. 219

5. Type and color of material	From	To
Overburden	0	120
Sand	120	135
Sand & clay streaked	135	165
Clay	165	180
Sand (good coarse)	180	214
Clay	214	218

10. Screen: Manufacturer's name W. A. Brown Type Free Flo Dia. 16 Slot/gauze slot Length 20 ft. Set between 120 ft. and 218 ft. ft. and <input type="checkbox"/> ft. Gravel pack? yes Size range of material 3/4
11. Static water level: <input type="checkbox"/> mo./day/yr. 160 ft. below land surface Date 6-9-76
12. Pumping level below land surfaces: 175 ft. after 4 hrs. pumping 1200 g.p.m. <input type="checkbox"/> ft. after <input type="checkbox"/> hrs. pumping <input type="checkbox"/> g.p.m. Estimated maximum yield 1500 g.p.m.
13. Water sample submitted: <input type="checkbox"/> mo./day/yr. Yes <input checked="" type="checkbox"/> No <input type="checkbox"/> Date
14. Well head completion: <input type="checkbox"/> Pitless adapter 12 inches above grade
15. Well grouted? yes With: <input type="checkbox"/> Neat cement <input checked="" type="checkbox"/> Bentonite <input type="checkbox"/> Concrete Depth: From 0 ft. to 10 ft.
16. Nearest source of possible contamination: ft. <input type="checkbox"/> Direction <input type="checkbox"/> Type None Well disinfected upon completion? <input type="checkbox"/> Yes <input checked="" type="checkbox"/> No
17. Pump: <input type="checkbox"/> Not installed Manufacturer's name Layne Model number 81185K HP 75 Volts <input type="checkbox"/> Length of drop pipe 200 ft. capacity 800 g.p.m. Type: <input type="checkbox"/> Submersible <input checked="" type="checkbox"/> Turbine <input type="checkbox"/> Jet <input type="checkbox"/> Reciprocating <input type="checkbox"/> Centrifugal <input type="checkbox"/> Other

18. Elevation:	19. Remarks: Level
Topography: <input type="checkbox"/> Hill <input type="checkbox"/> Slope <input type="checkbox"/> Upland <input type="checkbox"/> Valley	

20. Water well contractor's certification: This well was drilled under my jurisdiction and this report is true to the best of my knowledge and belief. ARK VALLEY PUMP & SUPPLY 123 Business name License No. Address Box 235, Holly, Colo. Signed W. Smith Date 6-28-76 Authorized representative

T 16 S
 R 40 E/W
 Sec 12 CSE
 1/4 1/4 1/4