


Cavenee

1 LOCATION OF WATER WELL: Fraction SW 1/4 NW 1/4 NW 1/4 Section Number 23 Township Number T 16 S Range Number R 41 EW
 County: Greeley
 Distance and direction from nearest town or city street address of well if located within city?

2 WATER WELL OWNER: Myron Sell
 RR#, St. Address, Box #: P. O. Box 3769 Board of Agriculture, Division of Water Resources
 City, State, ZIP Code: Page, AZ 86040 Application Number: 10289

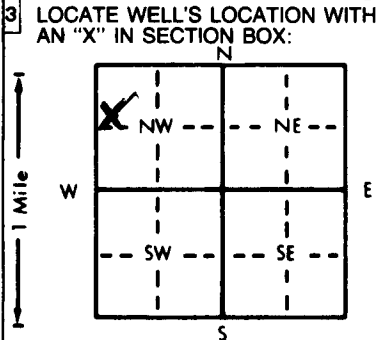

4 DEPTH OF COMPLETED WELL... 208 ft. ELEVATION:
 Depth(s) Groundwater Encountered 1. ft. 2. ft. 3. ft.
 WELL'S STATIC WATER LEVEL ... 155 ft. below land surface measured on mo/day/yr
 Pump test data: Well water was ft. after hours pumping gpm
 Est. Yield gpm: Well water was ft. after hours pumping gpm
 Bore Hole Diameter... 24 in. to 208 ft., and in. to ft.
 WELL WATER TO BE USED AS: 5 Public water supply 8 Air conditioning 11 Injection well
 1 Domestic 3 Feedlot 6 Oil field water supply 9 Dewatering 12 Other (Specify below)
2 Irrigation 4 Industrial 7 Lawn and garden only 10 Monitoring well
 Was a chemical/bacteriological sample submitted to Department? Yes.....No...X...; If yes, mo/day/yr sample was submitted
 Water Well Disinfected? Yes No X

5 TYPE OF BLANK CASING USED: 5 Wrought iron 8 Concrete tile CASING JOINTS: Glued .. X .. Clamped
 1 Steel 3 RMP (SR) 6 Asbestos-Cement 9 Other (specify below) Welded
 2 PVC 4 ABS 7 Fiberglass Threaded.....
 Blank casing diameter ... 16 in. to 148 ft. Dia in. to ft. Dia in. to ft.
 Casing height above land surface... 24 in., weight ... 16.15 lbs./ft. Wall thickness or gauge No. .500
 TYPE OF SCREEN OR PERFORATION MATERIAL: 7 PVC 10 Asbestos-cement
 1 Steel 3 Stainless steel 5 Fiberglass 8 RMP (SR) 11 Other (specify)
 2 Brass 4 Galvanized steel 6 Concrete tile 9 ABS 12 None used (open hole)
 SCREEN OR PERFORATION OPENINGS ARE: 5 Gauzed wrapped 8 Saw cut 11 None (open hole)
 1 Continuous slot 3 Mill slot 6 Wire wrapped 9 Drilled Holes
 2 Louvered shutter 4 Key punched 7 Torch cut 10 Other (specify)
 SCREEN-PERFORATED INTERVALS: From... 148 ft. to 208 ft., From ft. to ft.
 From ft. to ft., From ft. to ft.
 GRAVEL PACK INTERVALS: From... 20 ft. to 208 ft., From ft. to ft.
 From ft. to ft., From ft. to ft.

6 GROUT MATERIAL: 1 Neat cement 2 Cement grout 3 Bentonite 4 Other
 Grout Intervals: From... 0 ft. to 20 ft., From ft. to ft., From ft. to ft.
 What is the nearest source of possible contamination: None 10 Livestock pens 14 Abandoned water well
 1 Septic tank 4 Lateral lines 7 Pit privy 11 Fuel storage 15 Oil well/Gas well
 2 Sewer lines 5 Cess pool 8 Sewage lagoon 12 Fertilizer storage 16 Other (specify below)
 3 Watertight sewer lines 6 Seepage pit 9 Feedyard 13 Insecticide storage

Direction from well? How many feet?

| FROM | TO | LITHOLOGIC LOG | FROM | TO | PLUGGING INTERVALS |
|------|-----|---------------------------------|------|-----|------------------------------|
| 0 | 2 | Surface | 102 | 104 | Cemented Sand |
| 2 | 13 | Loess | 104 | 106 | Sand |
| 13 | 18 | Sand & Clay | 106 | 108 | Cemented Sand |
| 18 | 29 | Sandy Clay, Caliche & Sand Strk | 108 | 130 | Cem. Sand w/Clay & Sand Strk |
| 29 | 38 | Tight Sand-Cem. & Clay Strks. | 130 | 145 | Med. Sand-Semi-Tight |
| 38 | 50 | Cemented Strks. w/Clay | 145 | 150 | Loose Sand/Clay Lenses |
| 50 | 54 | Sand-Loose | 150 | 151 | Clay |
| 54 | 70 | Clay-Cemented Sand & Caliche | 151 | 155 | Sand-Loose |
| 70 | 75 | Clay & Sand Lenses | 155 | 160 | Clay & Sand Lenses |
| 75 | 79 | Med. Sand | 160 | 162 | Tight Sand |
| 79 | 80 | Cemented Sand | 162 | 167 | Cemented Sand & Clay |
| 80 | 93 | Clay-Sand & Cemented Strks. | 167 | 170 | Clay w/Sand Strks. |
| 93 | 97 | Med. Sand | 170 | 178 | Med. Sand w/Clay Lenses |
| 97 | 98 | Cemented Sand | 178 | 180 | Clay |
| 98 | 102 | Loose Sand 197-208 Ochre | 180 | 197 | Fine Med. Sand w/Clay Lens. |

7 CONTRACTOR'S OR LANDOWNER'S CERTIFICATION: This water well was (1) constructed, (2) reconstructed, or (3) plugged under my jurisdiction and was completed on (mo/day/year) 5-5-97 and this record is true to the best of my knowledge and belief. Kansas Water Well Contractor's License No. 554 This Water Well Record was completed on (mo/day/yr) 5-8-97 under the business name of Woofter Pump & Well, Inc. by (signature) *Gay C. Woofter*

INSTRUCTIONS: Use typewriter or ball point pen. PLEASE PRESS FIRMLY and PRINT clearly. Please fill in blanks, underline or circle the correct answers. Send top three copies to Kansas Department of Health and Environment, Bureau of Water, Topeka, Kansas 66620-0001. Telephone: 913-296-5545. Send one to WATER WELL OWNER and retain one for your records.

OFFICE USE ONLY
T
R
EW
SEC.
1/4
1/4
1/4