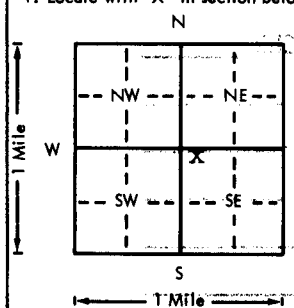


USE TYPEWRITER OR BALL  
POINT PEN-PRESS FIRMLY,  
PRINT CLEARLY.

WATER WELL RECORD  
KSA 82a-1201-1215

Kansas Department of Health and  
Environment-Division of Environment  
(Water well Contractors)  
Topeka, Kansas 66620

1. Location of well:		County <b>Greeley</b>	Fraction <b>NW 1/4 NW 1/4 SE 1/4</b>	Section number <b>6</b>	Township number <b>T 16</b>	Range number <b>S 41</b>	E <b>10</b>
2. Distance and direction from nearest town or city: <b>16N, 7 1/2 W, 1/2 S,</b> Street address of well location if in city: <b>of Tribune, KS</b>				3. Owner of well: <b>LaVern Kuder</b> R.R. or street: <b>Box 23</b> City, state, zip code: <b>Weskan, KS 67762</b>			
4. Locate with "X" in section below:  Sketch map: <b>Septic</b> <b>1/2 mi.</b> <b>X well</b>				6. Bore hole dia. <b>26</b> in. Completion date <b>8-8-74</b> Well depth <b>270</b> ft.			
5. Type and color of material				7. <input type="checkbox"/> Cable tool <input type="checkbox"/> Rotary <input type="checkbox"/> Driven <input type="checkbox"/> Dug <input type="checkbox"/> Hollow rod <input type="checkbox"/> Jetted <input type="checkbox"/> Bored <input checked="" type="checkbox"/> Reverse rotary			
				8. Use: <input type="checkbox"/> Domestic <input type="checkbox"/> Public supply <input type="checkbox"/> Industry <input checked="" type="checkbox"/> Irrigation <input type="checkbox"/> Air conditioning <input type="checkbox"/> Stock <input type="checkbox"/> Lawn <input type="checkbox"/> Oil field water <input type="checkbox"/> Other			
9. Casing: Material <b>Steel</b> Height: <b>Above</b> or below Threaded <input type="checkbox"/> Welded <input checked="" type="checkbox"/> Surface <b>10</b> in. RMP <input type="checkbox"/> PVC <input type="checkbox"/> Weight <b>31.67</b> lbs./ft. Dia. <b>16</b> in. to <b>270</b> ft. depth Wall Thickness: inches or Dia. <input type="checkbox"/> in. to <input type="checkbox"/> ft. depth Gage No. <b>188</b>				10. Screen: Manufacturer's name <b>Free Flow</b> Type <b>Prime Steel</b> Dia. <b>16 in.</b> <input checked="" type="checkbox"/> Slotted gauze <b>125</b> Length <b>60 ft.</b> Set between <b>210</b> ft. and <b>270</b> ft. Gravel pack? <b>yes</b> Size range of material <b>3/4-1/2</b> ft.			
				11. Static water level: <b>160</b> ft. below land surface Date <b>7-26-74</b> 12. Pumping level below land surfaces: <b>205</b> ft. after <b>4</b> hrs. pumping <b>1150</b> g.p.m. <b>221</b> ft. after <b>4</b> hrs. pumping <b>1600</b> g.p.m. Estimated maximum yield <b>1600</b> g.p.m.			
13. Water sample submitted: <input type="checkbox"/> Yes <input checked="" type="checkbox"/> No Date <b>7-26-74</b> 14. Well head completion: <input checked="" type="checkbox"/> Pitless adapter <b>12</b> inches above grade 15. Well grouted? <b>yes</b> With: <input type="checkbox"/> Neat cement <input type="checkbox"/> Bentonite <input checked="" type="checkbox"/> Concrete Depth: From <b>0</b> ft. to <b>10</b> ft.				16. Nearest source of possible contamination: ft. <b>2640</b> Direction <b>N</b> Type <b>Septic</b> Well disinfected upon completion? <input checked="" type="checkbox"/> Yes <input type="checkbox"/> No			
				17. Pump: Manufacturer's name <b>Western Land Roller</b> Model number <b>260</b> HP <b>1600</b> Volts <b>1600</b> Length of drop pipe <b>260</b> ft. capacity <b>1600</b> p.m. Type: <input type="checkbox"/> Submersible <input checked="" type="checkbox"/> Turbine <input type="checkbox"/> Jet <input type="checkbox"/> Reciprocating <input type="checkbox"/> Centrifugal <input type="checkbox"/> Other			
18. Elevation:		19. Remarks: <b>Clay</b> <b>Shale</b> <b>TOPO 3752</b> <b>280</b>		20. Water well contractor's certification: This well was drilled under my jurisdiction and this report is true to the best of my knowledge and belief. <b>Weishaar Drilling</b> <b>232</b> Business name License No. Address <b>Scottdale, KS 67871</b> Signature <b>[Signature]</b> Date <b>7-27-76</b> Authorized representative			