

USE TYPEWRITER OR BALL POINT PEN-PRESS FIRMLY, PRINT CLEARLY.


WATER WELL RECORD
KSA 82a-1201-1215

Kansas Department of Health and Environment-Division of Environment (Water well Contractors) Topeka, Kansas 66620

SHARDIST
3NE

1. Location of well: County **Greeley** Fraction **SW 1/4 NW 1/4 NE 1/4** Section number **13** Township number **T 16 S S R 41 W E/W** Range number

2. Distance and direction from nearest town or city: **1 1/2 mi. N, 2 W** 3. Owner of well: **Hoffman Farms, Inc.**
1 1/2 N & 1/2 W of Tribune, Kans. R.R. or street:
Street address of well location if in city: City, state, zip code: **Tribune, Kans. 67879**

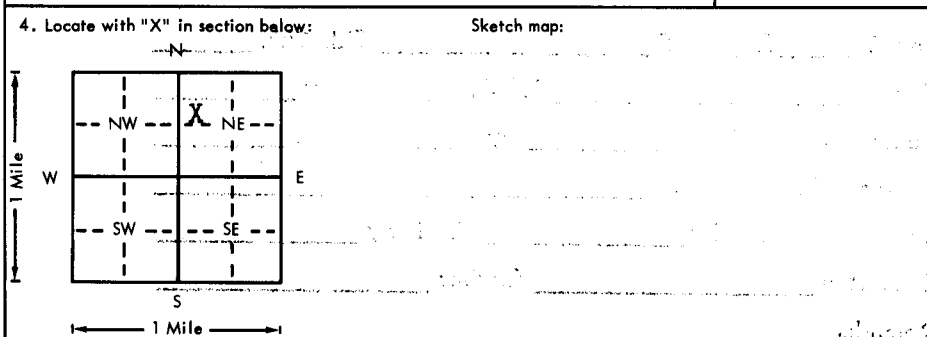

6. Bore hole dia. 26 in. Completion date _____
Well depth 223 ft. 8-14-78

7. Cable tool Rotary Driven Dug
 Hollow rod Jetted Bored Reverse rotary

8. Use: Domestic Public supply Industry
 Irrigation Air conditioning Stock
 Lawn Oil field water Other

9. Casing: Material steel Height: Above or below _____
Threaded _____ Welded Surface 12 in.
RMP _____ PVC _____ Weight 40 lbs./ft.
Dia. 16 in. to 163 ft. depth Wall Thickness: inches or
Dia. _____ in. to _____ ft. depth Gage No. .219

5. Type and color of material	From	To
Top soil & clay	0	10
Clay & Lime stone	10	68
Sand, 2' Hard lime & clay	68	75
Clay & Lime stone	75	105
Sandy clay & 1' Hard Lime	105	120
Sand	120	128
Clay, Lime & little Sand	128	150
Cemented sand, Clay & 1' Sand	150	154
Clay	154	165
Sand	165	167
Clay	167	180
Sand (fine)	180	195
Clay & hard Lime	195	203
Sand (coarse)	203	210
Sand	210	218
Clay	218	220
Shale	220	223
(Use a second sheet if needed)		

10. Screen: Manufacturer's name XXXXXXXX W.A. Brown
Type Perf. Dia. 16
Slot/gauze slot Length 60
Set between 163 ft. and 223 ft.
_____ ft. and _____ ft.
Gravel pack? yes Size range of material 3/4

11. Static water level: _____ mo./day/yr.
170 ft. below land surface Date 8-10-78

12. Pumping level below land surfaces:
218 ft. after 2 hrs. pumping 900 g.p.m.
_____ ft. after _____ hrs. pumping _____ g.p.m.
Estimated maximum yield 900 g.p.m.

13. Water sample submitted: _____ mo./day/yr.
Yes No Date _____

14. Well head completion:
 Pitless adapter 12 Inches above grade

15. Well grouted? Yes
With: Neat cement Bentonite Concrete
Depth: From 0 ft. to 10 ft.

16. Nearest source of possible contamination:
ft. _____ Direction _____ Type None
Well disinfected upon completion? _____ Yes No

17. Pump: _____ Not installed
Manufacturer's name Set old pump
Model number _____ HP _____ Volts _____
Length of drop pipe 220 ft. capacity _____ g.p.m.
Type:
 Submersible Turbine
 Jet Reciprocating
 Centrifugal Other

18. Elevation: Topography: _____ Hill _____ Slope _____ Upland _____ Valley _____

19. Remarks: **Level ground**
topo 3700

20. Water well contractor's certification:
This well was drilled under my jurisdiction and this report is true to the best of my knowledge and belief.
Ark Valley Pump & Supply 123
Business name Box 235 License No. _____
Address _____
Signed Wm Smith Date 9-20
Authorized representative

T 16 S S R 41 W E/W
1/4 1/4 1/4 1/4
SW NW NE