

USE TYPEWRITER OR BALL POINT PEN-PRESS FIRMLY, PRINT CLEARLY.


WATER WELL RECORD  
KSA 82a-1201-1215

3 NE

Kansas Department of Health and Environment-Division of Environment  
(Water well Contractors)  
Topeka, Kansas 66620

1. Location of well: County **Greeley** Fraction **SW 1/4 NW/4 SE 1/4** Section number **16** Township number **T 16 S R 41** Range number **E 11**

2. Distance and direction from nearest town or city: **13N, 5 1/2 W, 1/4 N of** 3. Owner of well: **Smith Ranch**  
Street address of well location if in city: **Tribune, KS** R.R. or street:  
City, state, zip code: **Tribune, KS 67879**

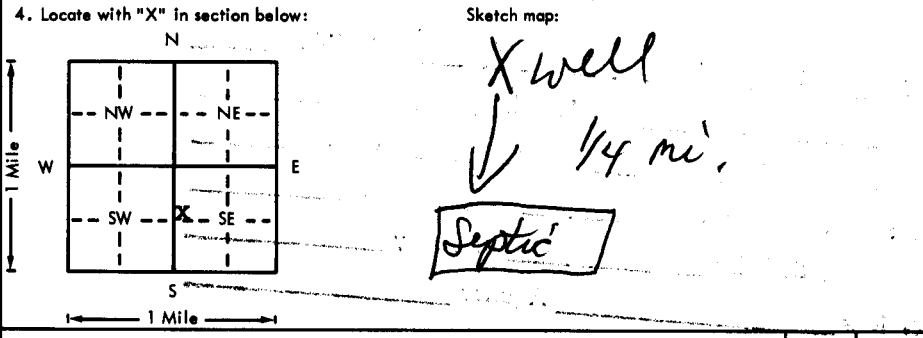

6. Bore hole dia. 26 in. Completion date \_\_\_\_\_  
Well depth 217 ft. 5-15-76

7.  Cable tool  Rotary  Driven  Dug  
 Hollow rod  Jetted  Bored  Reverse rotary

8. Use:  Domestic  Public supply  Industry  
 Irrigation  Air conditioning  Stock  
 Lawn  Oil field water  Other

9. Casing: Material Steel Height: Above or below  
Threaded  Welded  Surface 10 in.  
RMP  PVC  Weight 31.67 lbs./ft.  
Dia. 16 in. to 217 ft. depth Wall Thickness: inches or  
Dia. \_\_\_\_\_ in. to \_\_\_\_\_ ft. depth Gage No. 188

5. Type and color of material	From	To
Clay	0	30
Sdy clay	30	45
Sd coarse	45	52
Fine sd clay	52	68
Sd rock	68	70
Sdy clay T	70	85
Sd coarse	85	95
Fine sd clay	95	107
Sd coarse T	107	116
Fine sd clay	116	169
Sd coarse	169	208
Sd rock	208	210
Sd coarse	210	215
Clay yellow	215	220
Shale	220	

10. Screen: Manufacturer's name **Free Flow**  
Type **Prime Steel** Dia. **16 in.**  
Dia. gauge **.125** Length **50 ft.**  
Set between **167** ft. and **217** ft.  
ft. and \_\_\_\_\_ ft.  
Gravel pack?  Yes Size range of material **3/4-#**

11. Static water level: \_\_\_\_\_ mo./day/yr.  
146 ft. below land surface Date 4-17-76

12. Pumping level below land surfaces:  
193 ft. after 4 hrs. pumping 1520 g.p.m.  
200 ft. after 4 hrs. pumping 1610 g.p.m.  
Estimated maximum yield 1610 g.p.m.

13. Water sample submitted: \_\_\_\_\_ mo./day/yr.  
Yes  No  Date \_\_\_\_\_

Well head completion:  
 Pitless adapter 12 inches above grade

Well grouted? \_\_\_\_\_  
With:  Neat cement  Bentonite  Concrete  
Depth: From 0 ft. to 10 ft.

16. Nearest source of possible contamination:  
ft. 1320 Direction S Type Septic  
Well disinfected upon completion?  Yes  No

17. Pump: \_\_\_\_\_ Not installed  
Manufacturer's name **Simmons**  
Model number \_\_\_\_\_ HP \_\_\_\_\_ Volts \_\_\_\_\_  
Length of drop pipe 200 ft. capacity 1610 g.p.m.  
Type:  
 Submersible  Turbine  
 Jet  Reciprocating  
 Centrifugal  Other

18. Elevation: \_\_\_\_\_  
19. Remarks: **TOPO 3715**

Topography:  
 Hill  
 Slope  
 Upland  
 Valley

20. Water well contractor's certification:  
This well was drilled under my jurisdiction and this report is true to the best of my knowledge and belief.  
**Weishaar Drilling** 232  
Business name \_\_\_\_\_ License No. \_\_\_\_\_  
Address **Scott City, KS 67871**  
Signature *[Signature]* Date 7-21-76  
Authorized representative

16 41 16 SW 1/4 1/4