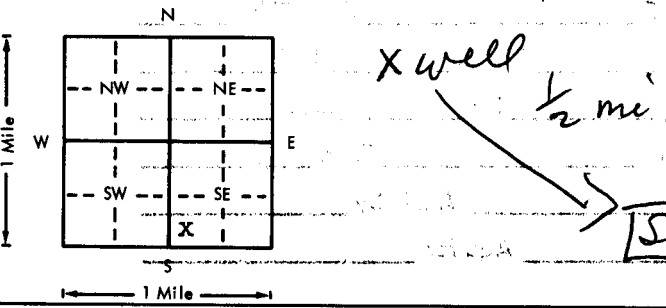


USE TYPEWRITER OR BALL POINT PEN-PRESS FIRMLY, PRINT CLEARLY.

WATER WELL RECORD
KSA 82a-1201-1215

Kansas Department of Health and Environment-Division of Environment
(Water well Contractors)
Topeka, Kansas 66620

1. Location of well:		County Greeley	Fraction SW 1/4 SW 1/4 SE 1/4	Section number 18	Township number T 16 S R 41 E	Range number 41 E
2. Distance and direction from nearest town or city: 1 1/2 N, 7 1/2 W, 1/4 N of Street address of well location if in city: Tribune, KS				3. Owner of well: Kim Voth R.R. or street: Box 403 City, state, zip code: Sharon Springs, KS 67758		
4. Locate with "X" in section below: Sketch map: 				6. Bore hole dia. 26 in. Completion date _____ Well depth 225 ft. 7-8-75		
5. Type and color of material				7. <input type="checkbox"/> Cable tool <input type="checkbox"/> Rotary <input type="checkbox"/> Driven <input type="checkbox"/> Dug <input type="checkbox"/> Hollow rod <input type="checkbox"/> Jetted <input type="checkbox"/> Bored <input checked="" type="checkbox"/> Reverse rotary		
				8. Use: <input type="checkbox"/> Domestic <input type="checkbox"/> Public supply <input type="checkbox"/> Industry <input checked="" type="checkbox"/> Irrigation <input type="checkbox"/> Air conditioning <input type="checkbox"/> Stock <input type="checkbox"/> Lawn <input type="checkbox"/> Oil field water <input type="checkbox"/> Other		
				9. Casing: Material Steel Height: Above or below Threaded <input type="checkbox"/> Welded <input checked="" type="checkbox"/> Surface 10 in. RMP <input type="checkbox"/> PVC <input type="checkbox"/> Weight 31.67 lbs./ft. Dia. 16 in. 225 ft. depth Wall Thickness: inches 1/8 Dia. _____ in. to _____ ft. depth gage No. 188		
				10. Screen: Manufacturer's name _____ Free Flow Type Prime Steel Dia. 16 in. <input checked="" type="checkbox"/> Gauze .125 Length 40 ft. Set between 185 ft. and 225 ft. _____ ft. and _____ ft. Gravel pack? <input checked="" type="checkbox"/> yes Size range of material 1/8 x 1/8		
				11. Static water level: _____ mo./day/yr. 168 ft. below land surface Date 9-6-74		
				12. Pumping level below land surfaces: 208 ft. after 4 hrs. pumping 530 g.p.m. 211 ft. after 4 hrs. pumping 350 g.p.m. Estimated maximum yield 550 g.p.m.		
				13. Water sample submitted: _____ mo./day/yr. Yes <input checked="" type="checkbox"/> No <input type="checkbox"/> Date _____		
				<input checked="" type="checkbox"/> Well head completion: <input type="checkbox"/> Pitless adapter 12 inches above grade		
				<input checked="" type="checkbox"/> Well grouted? _____ With: <input type="checkbox"/> Neat cement <input type="checkbox"/> Bentonite <input checked="" type="checkbox"/> Concrete Depth: From 0 ft. to 10 ft.		
				16. Nearest source of possible contamination: ft. 2640 Direction SE Type Septic Well disinfected upon completion? <input checked="" type="checkbox"/> Yes <input type="checkbox"/> No		
				17. Pump: Manufacturer's name Simmons Not installed Model number _____ HP _____ Volts _____ Length of drop pipe 210 ft. capacity 550 g.p.m. Type: <input type="checkbox"/> Submersible <input checked="" type="checkbox"/> Turbine <input type="checkbox"/> Jet <input type="checkbox"/> Reciprocating <input type="checkbox"/> Centrifugal <input type="checkbox"/> Other		
18. Elevation:		19. Remarks:		20. Water well contractor's certification: This well was drilled under my jurisdiction and this report is true to the best of my knowledge and belief. Weishaar Drilling 232 Business name License No. Address Scott City, KS 67871 Signed <i>[Signature]</i> Date 7-17-76 Authorized representative		
Topography: <input type="checkbox"/> Hill <input type="checkbox"/> Slope <input checked="" type="checkbox"/> Upland <input type="checkbox"/> Valley		Sd med Clay yellow Shale				

10 7 18 SWS USE 1/4 1/4 1/4