


WATER WELL RECORD Form WWC-5 KSA 82a-1212

1 LOCATION OF WATER WELL: Fraction SE 1/4 SE 1/4 NE 1/4 Section Number 22 Township Number T 16 S Range Number R 42

Distance and direction from nearest town or city street address of well if located within city?  
 12 1/2 N 9W of Tribune

2 WATER WELL OWNER: Young Cattle Co.  
 RR#, St. Address, Box # : RT 1 Box 57 Board of Agriculture, Division of Water Resources  
 City, State, ZIP Code : Tribune KS 67850 Application Number: 1143.01

3 LOCATE WELL'S LOCATION WITH AN "X" IN SECTION BOX:

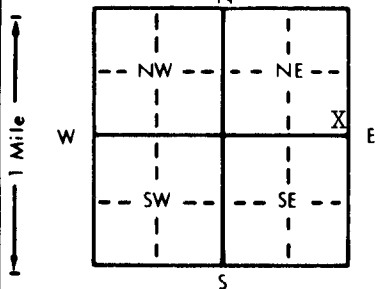

4 DEPTH OF COMPLETED WELL... 230 ft. ELEVATION:

Depth(s) Groundwater Encountered 1. 180 ft. 2. ft. 3. ft.  
 WELL'S STATIC WATER LEVEL... 180 ft. below land surface measured on mo/day/yr  
 Pump test data: Well water was 216 ft. after 2 hours pumping 15 gpm  
 Est. Yield... 25 gpm: Well water was ft. after hours pumping gpm  
 Bore Hole Diameter... 9.75 in. to ft. and in. to ft.  
 WELL WATER TO BE USED AS: 5 Public water supply 8 Air conditioning 11 Injection well  
 1 Domestic 3 Feedlot 6 Oil field water supply 9 Dewatering 12 Other (Specify below)  
 2 Irrigation 4 Industrial 7 Lawn and garden only 10 Monitoring well  
 Was a chemical/bacteriological sample submitted to Department? Yes No ; If yes, mo/day/yr sample was submitted Water Well Disinfected? Yes  No

5 TYPE OF CASING USED: 5 Wrought iron 8 Concrete tile CASING JOINTS: Glued  Clamped  
 1 Steel 3 RMP (SR) 6 Asbestos-Cement 9 Other (specify below) Welded  
 2 PVC 4 ABS 7 Fiberglass Threaded

Blank casing diameter... 5 in. to 190 ft. Dia in. to ft. Dia in. to ft.  
 Casing height above land surface... 24 in. weight lbs./ft. Wall thickness or gauge No.

TYPE OF SCREEN OR PERFORATION MATERIAL: 7 PVC 10 Asbestos-cement  
 1 Steel 3 Stainless steel 5 Fiberglass 8 RMP (SR) 11 Other (specify)  
 2 Brass 4 Galvanized steel 6 Concrete tile 9 ABS 12 None used (open hole)

SCREEN OR PERFORATION OPENINGS ARE: 5 Gauzed wrapped 8 Saw cut 11 None (open hole)  
 1 Continuous slot 3 Mill slot 6 Wire wrapped 9 Drilled holes  
 2 Louvered shutter 4 Key punched 7 Torch cut 10 Other (specify)

SCREEN-PERFORATED INTERVALS: From 190 ft. to 230 ft. From ft. to ft.  
 GRAVEL PACK INTERVALS: From 80 ft. to 230 ft. From ft. to ft.

6 GROUT MATERIAL: 1 Neat cement 2 Cement grout 3 Bentonite 4 Other  
 Grout intervals: From 5 ft. to 80 ft. From ft. to ft. From ft. to ft.

What is the nearest source of possible contamination:  
 1 Septic tank 4 Lateral lines 7 Pit privy 10 Livestock pens 14 Abandoned water well  
 2 Sewer lines 5 Cess pool 8 Sewage lagoon 11 Fuel storage 15 Oil well/Gas well  
 3 Watertight sewer lines 6 Seepage pit 9 Feedyard 12 Fertilizer storage 16 Other (specify below)  
 13 Insecticide storage

Direction from well? South How many feet? 100'

FROM	TO	LITHOLOGIC LOG	FROM	TO	PLUGGING INTERVALS
0	16	Topsoil, sandy clay and caliche			
16	32	Caliche and cemented sand			
32	49	Sand medium to coarse			
49	82	Sandy clay and caliche			
82	98	Clay sand and little caliche streaks			
98	114	Sandy clay			
114	132	Sand fine to medium			
132	164	Sandy clay and caliche			
164	213	Sand med to coarse and 12' clay			
213	218	Sand medium to coarse			
218	229	Yellow clay			
229	230	Shale			

7 CONTRACTOR'S OR LANDOWNER'S CERTIFICATION: This water well was (1) constructed, (2) reconstructed, or (3) plugged under my jurisdiction and was completed on (mo/day/year) 1-31-97 and this record is true to the best of my knowledge and belief. Kansas Water Well Contractor's License No. 473 This Water Well Record was completed on (mo/day/yr) 1-31-97 under the business name of Tyler Water Well Service Inc. by (signature) Paul G. G...

INSTRUCTIONS: Use typewriter or ball point pen. PLEASE PRESS FIRMLY and PRINT clearly. Please fill in blanks, underline or circle the correct answers. Send top three copies to Kansas Department of Health and Environment, Bureau of Water, Topeka, Kansas 66620-0001. Telephone: 913-296-5545. Send one to WATER WELL OWNER and retain one for your records.