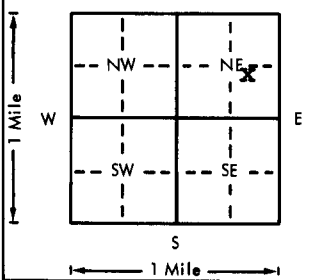


USE TYPEWRITER OR BALL
POINT PEN-PRESS FIRMLY,
PRINT CLEARLY.

WATER WELL RECORD
KSA 82a-1201-1215

Kansas Department of Health and
Environment-Division of Environment
(Water well Contractors)
Topeka, Kansas 66620

| | | | | | | |
|---|--|------------------------------------------|-----------------------------------------|---|----------------------------------|-----------------------------|
| 1. Location of well: | | County Greeley | Fraction NW 1/4 SE 1/4 NE 1/4 | Section number 15 | Township number T 16 S | Range number R 42 |
| 2. Distance and direction from nearest town or city: 13 N., 10 W., 1 N. of Tribune. | | 3. Owner of well: Verdel Young | | R.R. or street: Tribune, Ks. 67879 | | |
| Street address of well location if in city: | | City, state, zip code: | | | | |
| 4. Locate with "X" in section below: | | Sketch map: | | 6. Bore hole dia. 26 in. Completion date 6-10-77 Well depth 256 ft. | | |
|  | | | | 7. Cable tool <input type="checkbox"/> Rotary <input type="checkbox"/> Driven <input type="checkbox"/> Dug <input type="checkbox"/> Hollow rod <input type="checkbox"/> Jetted <input type="checkbox"/> Bored <input checked="" type="checkbox"/> Reverse rotary | | |
| 5. Type and color of material | | From | To | 8. Use: Domestic <input type="checkbox"/> Public supply <input type="checkbox"/> Industry <input checked="" type="checkbox"/> Irrigation <input type="checkbox"/> Air conditioning <input type="checkbox"/> Stock <input type="checkbox"/> Lawn <input type="checkbox"/> Oil field water <input type="checkbox"/> Other | | |
| | | | | 9. Casing: Material steel Height: Above or below grade Threaded <input type="checkbox"/> Welded <input checked="" type="checkbox"/> Surface 12 in. RMP <input type="checkbox"/> PVC <input type="checkbox"/> Weight 36.87 lbs./ft. Dia. 16 in. to 257 ft. depth Wall Thickness: inches or Dia. <input type="checkbox"/> in. to <input type="checkbox"/> ft. depth gage No. 250 | | |
| | | | | 10. Screen: Manufacturer's name Johnson Type galv. Dia. 16" Slot/gauge <input type="checkbox"/> Length 20 ft. Set between 230 ft. and 250 ft. Perf: 200-230 ft. and 250-256 ft. Gravel pack? yes Size range of material 3/4" down | | |
| | | | | 11. Static water level: <input type="checkbox"/> mo./day/yr. 204 ft. below land surface Date 4-29-77 | | |
| | | | | 12. Pumping level below land surfaces: 245 ft. after 5 hrs. pumping 450 g.p.m. <input type="checkbox"/> ft. after <input type="checkbox"/> hrs. pumping <input type="checkbox"/> g.p.m. Estimated maximum yield 450 g.p.m. | | |
| | | | | 13. Water sample submitted: <input type="checkbox"/> mo./day/yr. Yes <input checked="" type="checkbox"/> No <input type="checkbox"/> Date <input type="checkbox"/> | | |
| | | | | 14. Well head completion: <input type="checkbox"/> Pitless adapter 12 inches above grade | | |
| | | | | 15. Well grouted? yes With: <input type="checkbox"/> Neat cement <input type="checkbox"/> Bentonite <input checked="" type="checkbox"/> Concrete Depth: From 0 ft. to 10 ft. | | |
| | | | | 16. Nearest source of possible contamination: N/A ft. <input type="checkbox"/> Direction <input type="checkbox"/> Type <input type="checkbox"/> Well disinfected upon completion? <input type="checkbox"/> Yes <input checked="" type="checkbox"/> No | | |
| | | | | 17. Pump: <input type="checkbox"/> Not installed Manufacturer's name Goulds-US Pump Model number 10 JLO HP 40 Volts <input type="checkbox"/> Length of drop pipe 245 ft. capacity 400 g.p.m. Type: <input type="checkbox"/> Submersible <input checked="" type="checkbox"/> Turbine <input type="checkbox"/> Jet <input type="checkbox"/> Reciprocating <input type="checkbox"/> Centrifugal <input type="checkbox"/> Other | | |
| | | (Use a second sheet if needed) | | | | |
| 18. Elevation: | | 19. Remarks: | | 20. Water well contractor's certification: This well was drilled under my jurisdiction and this report is true to the best of my knowledge and belief. Minter-Wilson Drilling Co. 208 Business name License No. Address Box A Garden City, Ks. Signed [Signature] Date 4-30-77 Authorized representative | | |
| Topography: <input type="checkbox"/> Hill <input checked="" type="checkbox"/> Slope <input type="checkbox"/> Upland <input type="checkbox"/> Valley | | | | | | |

16 420 15
T R Sec
1/4 1/4 1/4
NW SE NE

Phone 276-8269 • P.O. Box A • GARDEN CITY, KANSAS 67846

VERDELL YOUNG
GREELEY COUNTY
3/16/77

Location: NE 15-16-42 north east corner

Static Water Level- 200

Test #6

| | | |
|-----|-----|---------------------------------------------|
| 0 | 2 | Top soil |
| 2 | 10 | Brown clay |
| 10 | 18 | Fine to med. sand |
| 18 | 67 | Brown sandy clay |
| 67 | 81 | Fine to med. sand and gravel 20% clay tight |
| 81 | 86 | Fine to med. sand and gravel |
| 86 | 97 | Brown sandy clay |
| 97 | 112 | Med. sand to med. coarse gravel |
| 112 | 120 | Brown sandy clay |
| 120 | 144 | Brown sandy clay 15% gravel Tight |
| 144 | 159 | Fine to med. sand |
| 159 | 187 | Brown sandy clay 15% sand and gravel |
| 187 | 194 | Fine to med. sand and gravel Tight |
| 194 | 200 | Brown sandy clay hard pull down |
| 200 | 209 | Fine to med. sand and gravel |
| 209 | 224 | Brown sandy clay |
| 224 | 251 | Fine to med. sand and gravel |
| 251 | 259 | Yellow clay |
| 259 | 262 | Shale |

T.D. 256
Screen 20
200' - Plain
30' - Perf
20' - Screen
6' - Perf