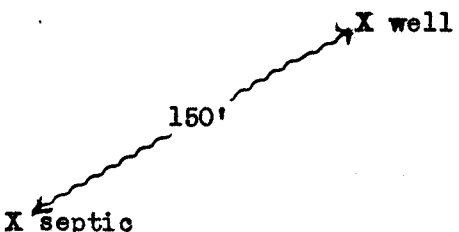


USE TYPEWRITER OR BALL
POINT PEN-PRESS FIRMLY,
PRINT CLEARLY.

WATER WELL RECORD
KSA 82a-1201-1215

Kansas Department of Health and
Environment-Division of Environment
(Water well Contractors)
Topeka, Kansas 66620

1. Location of well:		County Greeley	Fraction N/W 1/4 N/E 1/4 N/E 1/4	Section number 15	Township number T 16 S R 42 #/W
2. Distance and direction from nearest town or city: 13 N., 10 W., 1 N. of Tribune, Kansas Street address of well location if in city:				3. Owner of well: Verdell Young R.R. or street: Tribune, Kansas 67879 City, state, zip code:	
4. Locate with "X" in section below: N W E S 1 Mile		Sketch map: 		6. Bore hole dia. <u>9</u> in. Completion date <u>3/30/1979</u> Well depth <u>265</u> ft.	
5. Type and color of material		From	To	7. <u>X</u> Cable tool <u>X</u> Rotary <u> </u> Driven <u> </u> Dug <u> </u> Hollow rod <u> </u> Jetted <u> </u> Bored <u> </u> Reverse rotary	
clay		0	27	8. Use: <u>X</u> Domestic <u> </u> Public supply <u> </u> Industry <u> </u> Irrigation <u> </u> Air conditioning <u> </u> Stock <u> </u> Lawn <u> </u> Oil field water <u> </u> Other	
sand coarse		27	31	9. Casing: Material <u>Plastic</u> Height: Above or below Threaded <u> </u> Welded <u>glue</u> Surface <u>12</u> in. RMP <u>X</u> PVC <u> </u> Weight <u>1.8</u> lbs./ft. Dia. <u>5</u> in. to <u>245</u> ft. depth Wall Thickness: inches or Dia. <u> </u> in. to <u> </u> ft. depth Gauge No. <u>250</u>	
clay		31	33	10. Screen: Manufacturer's name <u>Jess & Lowell</u> Type <u>RMP</u> Dia. <u>5"</u> Slot/gauze <u>1/16</u> Length <u>20'</u> Set between <u>245</u> ft. and <u>265</u> ft. <u> </u> ft. and <u> </u> ft. Gravel pack? <u>yes</u> Size range of material <u>1/8" X 1/8"</u>	
gyp H.		33	50	11. Static water level: <u> </u> mo./day/yr. <u>205</u> ft. below land surface Date <u>3/27/79</u>	
clay		50	60	12. Pumping level below land surfaces: <u>228</u> ft. after <u>4</u> hrs. pumping <u>10</u> g.p.m. <u> </u> ft. after <u> </u> hrs. pumping <u> </u> g.p.m. Estimated maximum yield <u>10</u> g.p.m.	
fine sand clay		60	76	13. Water sample submitted: <u> </u> mo./day/yr. <u> </u> Yes <u>X</u> No Date <u> </u>	
sand coarse		76	85	14. Well head completion: <u>X</u> Pitless adapter <u>12</u> Inches above grade	
fine sand clay		85	95	15. Well grouted? <u>yes</u> With: <u>X</u> Neat cement <u> </u> Bentonite <u> </u> Concrete Depth: From <u>0</u> ft. to <u>15</u> ft.	
sand coarse		95	106	16. Nearest source of possible contamination: ft. <u>150</u> Direction <u>S/W</u> Type <u>Septic</u> Well disinfected upon completion? <u>X</u> Yes <u> </u> No	
fine sand clay		106	185	17. Pump: Manufacturer's name <u>Red Jacket</u> Model number <u>N14BC</u> HP <u>1</u> Volts <u>230</u> Length of drop pipe <u>260</u> ft. capacity <u>10</u> g.p.m. Type: <u>X</u> Submersible <u> </u> Turbine <u> </u> Jet <u> </u> Reciprocating <u> </u> Centrifugal <u> </u> Other	
sand coarse		185	192	18. Elevation:	
clay		192	195	19. Remarks:	
fine sand clay		195	217	(Use a second sheet if needed)	
sand coarse		217	225	20. Water well contractor's certification: This well was drilled under my jurisdiction and this report is true to the best of my knowledge and belief. <u>Weishaar Drilling & Sup. 232</u> Business name <u> </u> License No. <u> </u> Address <u>Scotch City, KS 67871</u> Signed <u> </u> Date <u>4/6/79</u> Authorized representative	
sandy clay coarse		225	231	Forward the white, blue and pink copies to the Department of Health and Environment	
sand coarse		231	238	Form WWC-5	
clay		238	250	1/4 1/4 1/4 1/4	
sand coarse		250	253	1/4 1/4 1/4 1/4	
fine sand clay		253	263	1/4 1/4 1/4 1/4	
shale		263	265	1/4 1/4 1/4 1/4	