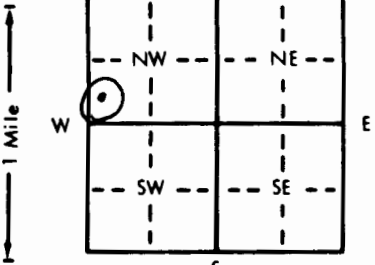


1 LOCATION OF WATER WELL: County: <u>Saline</u>	Fraction <u>SW 1/4 SW 1/4 NW 1/4</u>	Section Number <u>4</u>	Township Number T <u>16</u> S	Range Number R <u>5</u> EW
--	---	----------------------------	----------------------------------	-------------------------------

Distance and direction from nearest town or city street address of well if located within city?

2 WATER WELL OWNER: <u>MAFB / SHWR</u>	#47
RR#, St. Address, Box # : City, State, ZIP Code :	Board of Agriculture, Division of Water Resources Application Number:

3 LOCATE WELL'S LOCATION WITH AN "X" IN SECTION BOX: 	4 DEPTH OF COMPLETED WELL: <u>19'</u> ft. ELEVATION: Depth(s) Groundwater Encountered 1. <u>18</u> ft. 2. <u>18</u> ft. 3. <u>18</u> ft. WELL'S STATIC WATER LEVEL <u>18</u> ft. 





FROM	TO	LITHOLOGIC LOG	FROM	TO	PLUGGING INTERVALS
			0	5.5	Compacted Soil
			5.5	6	Cement
			6	18	Rock sides & compacted Soil
			18	19	chlorinated Sand fill

7 CONTRACTOR'S OR LANDOWNER'S CERTIFICATION: This water well was (1) constructed, (2) reconstructed, or (3) plugged under my jurisdiction and was completed on (mo/day/year) <u>8/18/92</u> and this record is true to the best of my knowledge and belief. 
--