


1 LOCATION OF WATER WELL: County: Saline	Fraction SW ¼ NW ¼ NW ¼	Section Number 8	Township Number T 16 S	Range Number R 5
---	----------------------------	---------------------	---------------------------	---------------------

Distance and direction from nearest town or city street address of well if located within city?
8 miles West & 1 mile North of Falun, KS

2 WATER WELL OWNER:	Chris Hoffman III	
RR#, St. Address, Box # :	100 S. Santa Fe, Box 560	Board of Agriculture, Division of Water Resources
City, State, ZIP Code :	Salina, KS 67401	Application Number:

LOCATE WELL'S LOCATION WITH AN "X" IN SECTION BOX: 4 DEPTH OF COMPLETED WELL: 77 ft. ELEVATION: 37

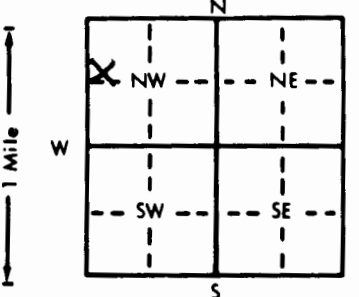

Depth(s) Groundwater Encountered 37 ft. below ~~land surface~~ ^{Top of Casing} measured on mo/day/yr 1-19-89 ft.

WELL'S STATIC WATER LEVEL

Pump test data: Well water was _____ ft. after _____ hours pumping _____ gpm

Est. Yield 4-4½ gpm: Well water was 25 ft. after 2 hours pumping 4½ gpm

Bore Hole Diameter 8 in. to 77 ft., and _____ in. to _____ ft.

WELL WATER TO BE USED AS:

5 Public water supply	8 Air conditioning	11 Injection well		
① Domestic	3 Feedlot	6 Oil field water supply	9 Dewatering	12 Other (Specify below)
2 Irrigation	4 Industrial	7 Lawn and garden only	10 Observation well	Stock Well

Was a chemical/bacteriological sample submitted to Department? Yes _____ No X _____; If yes, mo/day/yr sample was submitted _____

Water Well Disinfected? Yes X No _____

5 TYPE OF BLANK CASING USED:		5 Wrought iron	8 Concrete tile	CASING JOINTS: <u>Glued</u> Clamped	
1 Steel	3 RMP (SR)	6 Asbestos-Cement	9 Other (specify below)	Welded	
2 <u>PVC</u>	4 ABS	7 Fiberglass		Threaded	
Blank casing diameter 5 in. to 57 ft. Dia in. to ft. Dia in. to ft.					
Casing height above land surface 12 in. weight 2.91 lbs./ft. Wall thickness or gauge No. 265					

TYPE OF SCREEN OR PERFORATION MATERIAL:			7 <u>PVC</u>	10 Asbestos-cement
1 Steel	3 Stainless steel	5 Fiberglass	8 RMP (SR)	11 Other (specify)
2 Brass	4 Galvanized steel	6 Concrete tile	9 ABS	12 None used (open hole)

SCREEN OR PERFORATION OPENINGS ARE:

1 Continuous slot	3 Mill slot	5 Gauzed wrapped	8 Saw cut	11 None (open hole)
2 Louvered shutter	4 Key punched	6 Wire wrapped	9 Drilled holes	
		7 Torch cut	10 Other (specify)	

SCREEN-PERFORATED INTERVALS:	From	57	ft. to	77	ft. From		ft. to		ft.
	From		ft. to		ft. From		ft. to		ft.
GRAVEL PACK INTERVALS:	From	20	ft. to	77	ft. From		ft. to		ft.
	From		ft. to		ft. From		ft. to		ft.

1 Neat cement 2 Cement grout 3 Bentonite 4 Other

Grout Intervals: From 0 ft. to 20 ft., From ft. to ft., From ft. to ft.

What is the nearest source of possible contamination:

1 Septic tank	4 Lateral lines	7 Pit privy	10 Livestock pens	14 <u>Abandoned water well</u>
2 Sewer lines	5 Cess pool	8 Sewage lagoon	11 Fuel storage	15 Oil well/Gas well
3 Watertight sewer lines	6 Seepage pit	9 Feedyard	12 Fertilizer storage	16 Other (specify below)
			13 Insecticide storage
Direction from well? <u>East</u>			How many feet? <u>50</u>	

[illegible]

7 CONTRACTOR'S OR LANDOWNER'S CERTIFICATION: This water well was (1) constructed, (2) reconstructed, or (3) plugged under my jurisdiction and was completed on (mo/day/year) 1-19-89 and this record is true to the best of my knowledge and belief. Kansas Water Well Contractor's License No. 138 This Water Well Record was completed on (mo/day/yr) 1-23-89 under the business name of Peterson Irrigation, Inc. by (signature) Mike Peterson

INSTRUCTIONS: Use typewriter or ball point pen. PLEASE PRESS FIRMLY and PRINT clearly. Please fill in blanks, underline or circle the correct answers. Send top three copies to Kansas Department of Health and Environment, Bureau of Water Protection, Topeka, Kansas 66620-7320, Telephone: 913-862-9360. Send one to WATER WELL OWNER and retain one for your records.