


1 LOCATION OF WATER WELL:	Fraction	Section Number	Township Number	Range Number
County: <u>SALINE</u>	<u>SE</u> $\frac{1}{4}$ <u>SW</u> $\frac{1}{4}$ <u>SW</u> $\frac{1}{4}$	<u>24</u>	T <u>16</u> S	R <u>5</u> E <u>W</u>

2 WATER WELL OWNER: MCAFEE - SHUR

Board of Agriculture, Division of Water Resources  
Application Number:

4 DEPTH OF COMPLETED WELL... 2.7 ..... ft. ELEVATION: .....

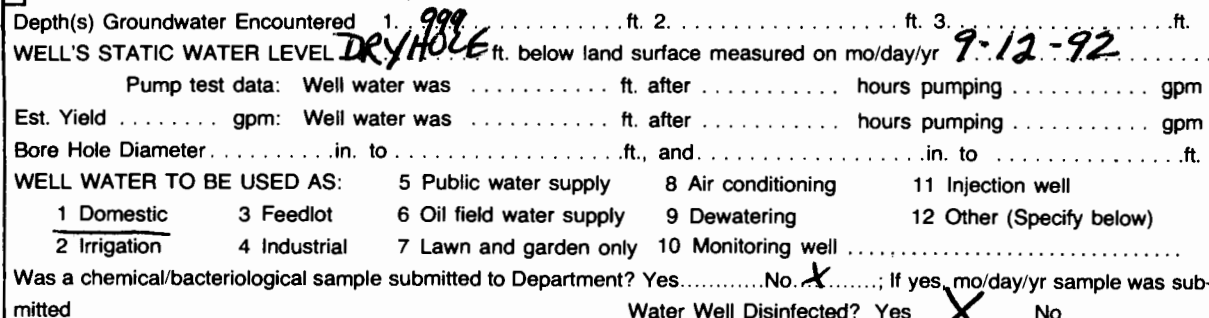

5 TYPE OF BLANK CASING USED:

- Blank casing diameter 6 in. to 3 1/2 ft., Dia. 1 weight 1 lbs./ft. Wall thickness or gauge No. 1

TYPE OF SCREEN OR PERFORATION MATERIAL:

- |         |                    |                 |            |                               |
|---------|--------------------|-----------------|------------|-------------------------------|
| 1 Steel | 3 Stainless steel  | 5 Fiberglass    | 8 RMP (SR) | 11 Other (specify) <i>N/A</i> |
| 2 Brass | 4 Galvanized steel | 6 Concrete tile | 9 ABS      | 12 None used (open hole)      |

SCREEN OR PERFORATION OPENINGS ARE:

- 1 Continuous slot  
2 Louvered shutter  
3 Mill slot  
4 Key punched  
5 Saw cut  
6 Wire wrapped  
7 Torch cut  
8 Drilled holes  
9 None (open hole)  
10 Other (specify) *N/A*

SCREEN-PERFORATED INTERVALS: From N/A ft. to N/A ft. From \_\_\_\_\_ ft. to \_\_\_\_\_ ft.

GRAVEL PACK INTERVALS:

6 GROUT MATERIAL: 1 Neat cement 2 Cement grout 3 Bentonite 4 Other

Great Intervals: From 3 ft to 9 ft From ft to ft From ft to ft

What is the nearest source of possible contamination: 10 Livestock pens 14 Abandoned water well

- |                          |                 |                 |                        |                          |
|--------------------------|-----------------|-----------------|------------------------|--------------------------|
| 1 Septic tank            | 4 Lateral lines | 7 Pit privy     | 11 Fuel storage        | 15 Oil well/Gas well     |
| 2 Sewer lines            | 5 Cess pool     | 8 Sewage lagoon | 12 Fertilizer storage  | 16 Other (specify below) |
| 3 Watertight sewer lines | 6 Seepage pit   | 9 Feedyard      | 13 Insecticide storage |                          |

Direction from well? \_\_\_\_\_ How many feet? \_\_\_\_\_

FROM	TO	LITHOLOGIC LOG	FROM	TO	PLUGGING INTERVALS
			0 3	3 9	Compacted Topsoil Cement
					Cleaned & Drilled out 9ft.

7 CONTRACTOR'S OR LANDOWNER'S CERTIFICATION: This water well was (1) constructed, (2) reconstructed, or (3) plugged under my jurisdiction and was completed on (mo/day/year) 9-12-92 and this record is true to the best of my knowledge and belief. Kansas Water Well Contractor's License No. 313 This Water Well Record was completed on (mo/day/yr) 10-1-92 under the business name of Jet Drilling by (signature) [Signature]

INSTRUCTIONS: Use typewriter or ball point pen. PLEASE PRESS FIRMLY and PRINT clearly. Please fill in blanks, underline or circle the correct answers. Send top three copies to Kansas Department of Health and Environment, Bureau of Water, Topeka, Kansas 66620-0001. Telephone: 913-296-5545. Send one to WATER WELL OWNER and retain one for your records.