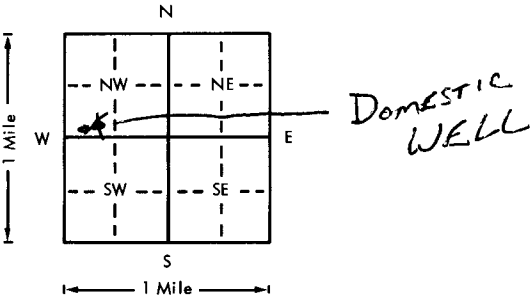


USE TYPEWRITER OR BALL
POINT PEN-PRESS FIRMLY,
PRINT CLEARLY.

WATER WELL RECORD
KSA 82a-1201-1215

Kansas Department of Health and
Environment-Division of Environment
(Water well Contractors)
Topeka, Kansas 66620

1. Location of well: County <u>ELLSWORTH</u> Fraction <u>SE 1/4 SW 1/4 NW 1/4</u> Section number <u>21</u> Township number <u>T 16 S</u> Range number <u>R 6 EW</u>	
2. Distance and direction from nearest town or city: <u>7 mi WEST AND 6 mi. NORTH OF MARQUETTE, KS</u> Street address of well location if in city: <u>6 mi. NORTH OF MARQUETTE, KS</u> 3. Owner of well: <u>Bob Nichols</u> R.R. or street: <u>CAMREN DEVELOPMENT</u> City, state, zip code: <u>Marquette, KS 67439</u>	
4. Locate with "X" in section below: Sketch map: 	
5. Type and color of material	
6. Bore hole dia. <u>8</u> in. Completion date <u>12-14-78</u> Well depth <u>30</u> ft.	
7. ☒ Cable tool ☒ Rotary ☐ Driven ☐ Dug ☐ Hollow rod ☐ Jetted ☐ Bored ☐ Reverse rotary	
8. Use: ☒ Domestic ☐ Public supply ☐ Industry ☐ Irrigation ☐ Air conditioning ☐ Stock ☐ Lawn ☐ Oil field water ☐ Other	
9. Casing: Material ☐ Height: <u>Above</u> or below Threaded ☐ Welded ☐ Surface <u>12</u> in. RMP ☐ PVC ☒ Weight <u>2</u> lbs./ft. Dia. <u>4</u> in. to <u>10</u> ft. depth Wall Thickness: inches or Dia. <u>4</u> in. to <u>10</u> ft. depth gage No. <u>25 in</u>	
10. Screen: Manufacturer's name <u>Peerless Plastics</u> Type <u>PVC</u> Dia. <u>4"</u> Slot/gauze <u>1/16</u> Length <u>20'</u> Set between <u>10</u> ft. and <u>30</u> ft. Gravel pack? <u>Yes</u> Size range of material <u>1/4</u>	
11. Static water level: <u>12</u> ft. below land surface Date <u>10-14-78</u>	
12. Pumping level below land surfaces: <u>14</u> ft. after <u>1</u> hrs. pumping <u>7-8</u> g.p.m. <u> </u> ft. after <u> </u> hrs. pumping <u> </u> g.p.m. Estimated maximum yield <u>8</u> g.p.m.	
13. Water sample submitted: <u> </u> mo./day/yr. Yes ☒ No ☐ Date <u> </u>	
14. Well head completion: <u> </u> Pitless adapter <u>12</u> inches above grade	
15. Well grouted? <u>Yes</u> With: ☒ Neat cement ☐ Bentonite ☐ Concrete Depth: From <u>0</u> ft. to <u>10</u> ft.	
16. Nearest source of possible contamination: ft. <u>2500</u> Direction <u>WEST</u> Type <u>LAKE</u> Well disinfected upon completion? ☒ Yes ☐ No	
17. Pump: ☒ Not installed Manufacturer's name <u> </u> Model number <u> </u> HP <u> </u> Volts <u> </u> Length of drop pipe <u> </u> ft. capacity <u> </u> g.p.m. Type: ☐ Submersible ☐ Turbine ☐ Jet ☐ Reciprocating ☐ Centrifugal ☐ Other	
18. Elevation: Topography: ☐ Hill ☐ Slope ☒ Upland ☐ Valley	
19. Remarks: (Use a second sheet if needed)	
20. Water well contractor's certification: This well was drilled under my jurisdiction and this report is true to the best of my knowledge and belief. <u>PETERSON IRRIGATION 138</u> Business name <u>Box 150, LINDSBURG, KS</u> License No. <u> </u> Address <u> </u> Signed <u>Mike Peterson</u> Date <u>1-3-79</u> Authorized representative	

Forward the white, blue and pink copies to the Department of Health and Environment

Form WWC-5