

WATER WELL PLUGGING RECORD Form WWC-5P

KSA 82a-1212

ID NO.

1 LOCATION OF WATER WELL: County: Ellsworth	Fraction SW 1/4 SE 1/4 SW 1/4 NE 1/4	Section Number 20	Township Number T 16 S	Range Number 7 ☐ E ☒ W
---	---	----------------------	---------------------------	--

Street/Rural Address of Well Location; if unknown, distance & direction from nearest town or intersection: If at owner's address, check here ☒

Global Positioning Systems (GPS) information:

Latitude: _____ (in decimal degrees)

Longitude: _____ (in decimal degrees)

Elevation: _____

Datum: ☐ WGS84, ☐ NAD83, ☐ NAD27

Collection Method:


☐ GPS unit (Make/Model: _____)

☐ Digital Map/Photo, ☐ Topographic Map, ☐ Land Survey

Est. Accuracy: ☐ < 3 m, ☐ 3-5 m, ☐ 5-15 m, ☐ > 15 m

2 WATER WELL OWNER: Jeremy Kootz
RR#, St. Address, Box #: 1656 21st Rd
City, State ZIP Code: Geneseo, KS 67444

3 MARK WELL'S LOCATION WITH AN "X" IN SECTION BOX:

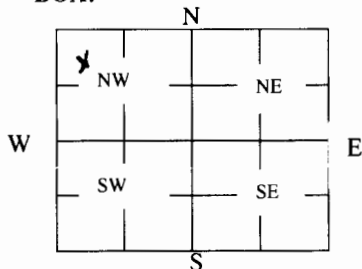

4 DEPTH OF WELL 162 ft.

WELL'S STATIC WATER LEVE 108 ft

WELL WAS USED AS:

- ☒ Domestic
☐ Irrigation
☐ Feedlot
☐ Industrial

- ☐ Public Water Supply
☐ Oil Field Water Supply
☐ Domestic (Lawn & Garden)
☐ Air Conditioning

- ☐ Dewatering
☐ Monitoring
☐ Injection Well
☐ Other _____

Was a chemical/bacteriological sample submitted to Department? Yes ☐ No ☒

5 TYPE OF BLANK CASING USED:

- ☐ Steel ☐ RMP (SR) ☐ Wrought ☐ Fiberglass ☐ Other (Specify below)
☒ PVC ☐ ABS ☐ Asbestos-Cement ☐ Concrete Tile

Blank casing diameter 5 in. Was casing pulled? Yes ☐ No ☒ If yes, how much _____
Casing height above or below land surface 60 in.

6 GROUT PLUG MATERIAL:

- ☐ Neat cement ☐ Cement grout ☒ Bentonite ☐ Other _____

Grout Plug Intervals: From _____ ft. to _____ ft., From _____ ft. to _____ ft., From _____ to _____ ft.

What is the nearest source of possible contamination:

- ☐ Septic tank ☐ Seepage pit ☐ Fuel Storage ☐ Other (specify below)
☐ Sewer lines ☐ Pit privy ☐ Fertilizer storage
☐ Watertight sewer lines ☐ Sewage lagoon ☐ Insecticide storage
☐ Lateral lines ☐ Feedyard ☐ Abandoned water well Direction from well? _____
☐ Cess pool ☐ Livestock pens ☐ Oil well/Gas well How many feet? _____

FROM	TO	PLUGGING MATERIALS	FROM	TO	PLUGGING MATERIALS
162'	50'	fill sand			
50'	6'	subsoil fill			
6'	3'	bentonite			
3'	0	top soil			

7 CONTRACTOR'S OR LANDOWNER'S CERTIFICATION: This water well was plugged under my jurisdiction and was completed on (mo/day/year) _____ and this record is true to the best of my knowledge and belief. Kansas Water Well Contractor's License No. _____. This Water Well Record was completed on (mo/day/year) 08/10/2013 under the business name of _____ Land owner _____ by (signature) Jeremy L. Kootz

INSTRUCTIONS: Use typewriter or ballpoint pen. Please press firmly and print clearly. Please fill in blanks, underline or circle the correct answers. Send top three copies to Kansas Department of Health and Environment, Bureau of Water, Geology Section, 1000 SW Jackson St., Ste. 420, Topeka, Kansas 66612-1367. Telephone: 785/296-5524. Send one to Water Well Owner and retain one for your records. Visit us at <http://www.kdheks.gov/waterwell/index.html>.

Check one: ☐ White Copy ☐ Blue Copy ☐ Pink Copy