


Well 2

WATER WELL PLUGGING RECORD Form WWC-5P KSA 82a-1212 ID NO.

1 LOCATION OF WATER WELL: Fraction 1/4 SW 1/4 SE 1/4 SW 1/4 Section Number 2 Township Number T 16 S Range Number 7 E W

Street/Rural Address of Well Location; if unknown, distance & direction from nearest town or intersection: If at owner's address, check here 1 1/4 South, 4 1/2 East of Kanopolis Global Positioning Systems (GPS) information: Latitude: 38.68357 Longitude: 98.06718

2 WATER WELL OWNER: U.S. Army Corps of Engineers RR#, St. Address, Box #: 4860 Outlet Blvd City, State ZIP Code: Sylvan Grove, KS 67481

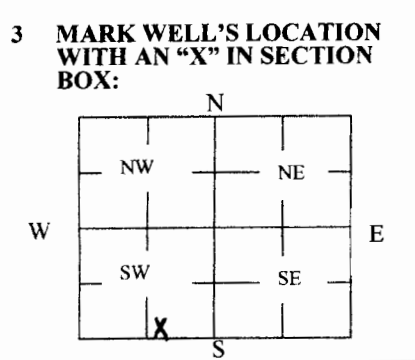

3 MARK WELL'S LOCATION WITH AN 'X' IN SECTION BOX: 4 DEPTH OF WELL 14 ft. WELL'S STATIC WATER LEVEL N/A ft. WELL WAS USED AS: Domestic, Irrigation, Feedlot, Industrial, Public Water Supply, Oil Field Water Supply, Domestic (Lawn & Garden), Air Conditioning, Dewatering, Monitoring, Injection Well, Other Windmill

5 TYPE OF BLANK CASING USED: Steel, PVC, RMP (SR), ABS, Wrought, Asbestos-Cement, Fiberglass, Concrete Tile, Other (Specify below) Blank casing diameter 5 in. Was casing pulled? Yes No If yes, how much Casing height above or below land surface 36 in.

6 GROUT PLUG MATERIAL: Neat cement, Cement grout, Bentonite, Other Grout Plug Intervals: From 6 ft. to 3 ft., From 14 ft. to 6 ft., From ft. to ft. What is the nearest source of possible contamination: Septic tank, Sewer lines, Watertight sewer lines, Lateral lines, Cess pool, Seepage pit, Pit privy, Sewage lagoon, Feedyard, Livestock pens, Fuel storage, Fertilizer storage, Insecticide storage, Abandoned water well, Oil well/Gas well, Other (specify below) None

Table with columns: FROM, TO, PLUGGING MATERIALS. Rows: 14 to 6 (Hole plug), 6 to 3 (Cement), 3 to 0 (Top soil)

7 CONTRACTOR'S OR LANDOWNER'S CERTIFICATION: This water well was plugged under my jurisdiction and was completed on (mo/day/year) 4-4-18 and this record is true to the best of my knowledge and belief. Kansas Water Well Contractor's License No. 134 This Water Well Record was completed on (mo/day/year) 4-12-18 under the business name of Rosencrantz- Bemis Ent Inc by (signature) Tara Aheff

Send one white copy to Kansas Department of Health & Environment, Geology Section, 1000 SW Jackson Street, Ste. 420, Topeka, KS 66612-1367. Send one copy to WATER WELL OWNER and retain one for your records. Visit us at http://www.kdheks.gov/waterwell/index.html Telephone 785-296-5524.