

Well 5

WATER WELL PLUGGING RECORD Form WWC-5P KSA 82a-1212 ID NO.


1 LOCATION OF WATER WELL: Fraction 1/4 NE 1/4 nw 1/4 NE 1/4 Section Number 9 Township Number T 16 S Range Number 7 [] E [x] W

Street/Rural Address of Well Location; if unknown, distance & direction from nearest town or intersection: If at owner's address, check here [] 1 1/4 South, 2 3/4 East of Kanopolis

Global Positioning Systems (GPS) information: Latitude: 38.681209 (in decimal degrees) Longitude: 98.098231 (in decimal degrees) Elevation: Horizontal Datum: [] WGS84, [x] NAD83, [] NAD27 Collection Method:

2 WATER WELL OWNER: U.S. Army Corps of Engineers RR#, St. Address, Box #: 4860 Outlet Blvd City, State ZIP Code: Sylvan Grove, KS 67481

[x] GPS unit (Make/Model: Digital Map/Photo, [] Topographic Map, [] Land Survey Est. Accuracy: [] < 3 m, [] 3-5 m, [] 5-15 m, [] > 15 m

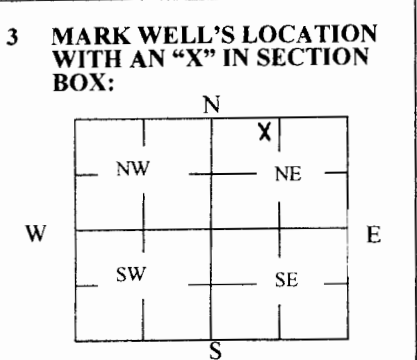

3 MARK WELL'S LOCATION WITH AN "X" IN SECTION BOX: 4 DEPTH OF WELL 57 ft. WELL'S STATIC WATER LEVEL 39 ft. WELL WAS USED AS: [] Domestic [] Irrigation [] Feedlot [] Industrial [] Public Water Supply [] Oil Field Water Supply [] Domestic (Lawn & Garden) [] Air Conditioning [] Dewatering [] Monitoring [] Injection Well [x] Other Windmill Was a chemical/bacteriological sample submitted to Department? Yes [] No [x]

5 TYPE OF BLANK CASING USED: [x] Steel [] PVC [] RMP (SR) [] ABS [] Wrought [] Asbestos-Cement [] Fiberglass [] Concrete Tile [] Other (Specify below) Blank casing diameter 5 in. Was casing pulled? Yes [] No [x] If yes, how much Casing height above or below land surface 36 in.

6 GROUT PLUG MATERIAL: [x] Neat cement [] Cement grout [x] Bentonite [] Other Grout Plug Intervals: From 6 ft. to 3 ft., From 57 ft. to 6 ft., From ft. to ft. What is the nearest source of possible contamination: [] Septic tank [] Sewer lines [] Watertight sewer lines [] Lateral lines [] Cess pool [] Seepage pit [] Pit privy [] Sewage lagoon [] Feedyard [] Livestock pens [] Fuel storage [] Fertilizer storage [] Insecticide storage [] Abandoned water well [] Oil well/Gas well [x] Other (specify below) None Direction from well? How many feet?

Table with 6 columns: FROM, TO, PLUGGING MATERIALS, FROM, TO, PLUGGING MATERIALS. Row 1: 57, 6, Hole plug. Row 2: 6, 3, Cement. Row 3: 3, 0, Top soil.

7 CONTRACTOR'S OR LANDOWNER'S CERTIFICATION: This water well was plugged under my jurisdiction and was completed on (mo/day/year) 4-4-18 and this record is true to the best of my knowledge and belief. Kansas Water Well Contractor's License No. 134. This Water Well Record was completed on (mo/day/year) 4-12-18 under the business name of Rosencrantz- Bemis Ent Inc by (signature) Nora Alefa

Send one white copy to Kansas Department of Health & Environment, Geology Section, 1000 SW Jackson Street, Ste. 420, Topeka, KS 66612-1367. Send one copy to WATER WELL OWNER and retain one for your records. Visit us at http://www.kdheks.gov/waterwell/index.html Telephone 785-296-5524.