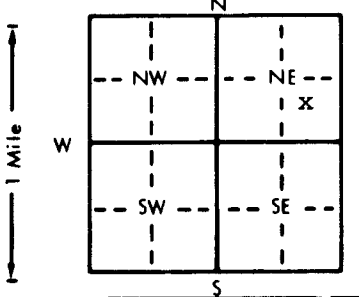


1 LOCATION OF WATER WELL:		Fraction	Section Number	Township Number	Range Number
County: Ellsworth		NW 1/4 SE 1/4 NE 1/4	22	T 16 S	R 8 E/W
Distance and direction from nearest town or city street address of well if located within city? N/A					
2 WATER WELL OWNER: Francis Soukup RR#, St. Address, Box # : R.R. 1 Box 187 City, State, ZIP Code : Ellsworth, KS 67439 Board of Agriculture, Division of Water Resources Application Number:					
3 LOCATE WELL'S LOCATION WITH AN "X" IN SECTION BOX:		4 DEPTH OF COMPLETED WELL: 42 ft. ELEVATION:			
		Depth(s) Groundwater Encountered 1. ft. 2. ft. 3. ft. WELL'S STATIC WATER LEVEL 31 ft. below land surface measured on mo/day/yr 12-30-92 Pump test data: Well water was ft. after hours pumping gpm Est. Yield gpm: Well water was ft. after hours pumping gpm Bore Hole Diameter in. to ft., and in. to ft. WELL WATER TO BE USED AS: 5 Public water supply 8 Air conditioning 11 Injection well 1 Domestic 3 Feedlot 6 Oil field water supply 9 Dewatering 12 Other (Specify below) 2 Irrigation 4 Industrial 7 Lawn and garden only 10 Monitoring well Was a chemical/bacteriological sample submitted to Department? Yes No <u>X</u> If yes, mo/day/yr sample was submitted Water Well Disinfected? Yes <u>X</u> No			
5 TYPE OF BLANK CASING USED:					
1 Steel 3 RMP (SR) 2 PVC 4 ABS		5 Wrought iron 8 Concrete tile 6 Asbestos-Cement 9 Other (specify below)		CASING JOINTS: Glued Clamped Welded Threaded	
Blank casing diameter 5 in. to ft., Dia in. to ft., Dia in. to ft. Casing height above land surface 36 in., weight lbs./ft. Wall thickness or gauge No. TYPE OF SCREEN OR PERFORATION MATERIAL:					
1 Steel 3 Stainless steel 5 Fiberglass 2 Brass 4 Galvanized steel 6 Concrete tile		7 PVC 10 Asbestos-cement 8 RMP (SR) 11 Other (specify) N/A 9 ABS 12 None used (open hole)			
SCREEN OR PERFORATION OPENINGS ARE:					
1 Continuous slot 3 Mill slot 2 Louvered shutter 4 Key punched		5 Gauzed wrapped 8 Saw cut 11 None (open hole) 6 Wire wrapped 9 Drilled holes 7 Torch cut 10 Other (specify) N/A			
SCREEN-PERFORATED INTERVALS: From N/A ft. to N/A ft., From ft. to ft. From ft. to ft., From ft. to ft. GRAVEL PACK INTERVALS: From ft. to ft., From ft. to ft. From ft. to ft., From ft. to ft.					
6 GROUT MATERIAL: 1 Neat cement 2 Cement grout 3 Bentonite 4 Other Grout Intervals: From 31 ft. to 26 ft., From 3 ft. to 0 ft., From ft. to ft. What is the nearest source of possible contamination:					
1 Septic tank 4 Lateral lines 7 Pit privy 2 Sewer lines 5 Cess pool 8 Sewage lagoon 3 Watertight sewer lines 6 Seepage pit 9 Feedyard		10 Livestock pens 14 Abandoned water well 11 Fuel storage 15 Oil well/Gas well 12 Fertilizer storage 16 Other (specify below) 13 Insecticide storage			
Direction from well? West		How many feet? 100			
FROM	TO	LITHOLOGIC LOG	FROM	TO	PLUGGING INTERVALS
			42	31	Chlorinated Sand
			31	26	Bentonite
			26	3	Sand
			3	0	Bentonite
7 CONTRACTOR'S OR LANDOWNER'S CERTIFICATION: This water well was (1) constructed, (2) reconstructed, or (3) plugged under my jurisdiction and was completed on (mo/day/year) 4-22-93 and this record is true to the best of my knowledge and belief. Kansas Water Well Contractor's License No. This Water Well Record was completed on (mo/day/yr) 4-22-93 under the business name of Water Quality Coordinator by (signature) Brad Kratzer					