


1 LOCATION OF WATER WELL: County: Morris Fraction: SE 1/4 SW 1/4 SE 1/4 Section Number: East 1/2 7 Township Number: T 16 S Range Number: R 8 E/W

Distance and direction from nearest town or city street address of well if located within city?
4 1/2 West & 1/2 North of Council Grove J4

2 WATER WELL OWNER: Steve Adams
 RR#, St. Address, Box #: 203 East MAIN
 City, State, ZIP Code: Council Grove Ks 66846
 Board of Agriculture, Division of Water Resources
 Application Number:

3 LOCATE WELL'S LOCATION WITH AN "X" IN SECTION BOX: 4 DEPTH OF COMPLETED WELL: 71 ft. ELEVATION:

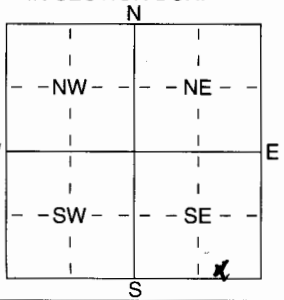

Depth(s) Groundwater Encountered: 1 43 ft. 2 ft. 3 ft.
 WELL'S STATIC WATER LEVEL: 40 ft. below land surface measured on mo/day/yr Sep 30 05
 Pump test data: Well water was ft. after hours pumping gpm
 Est. Yield 10+ gpm: Well water was ft. after hours pumping gpm
 WELL WATER TO BE USED AS:
 1 Domestic 3 Feedlot 6 Oil field water supply 9 Dewatering 12 Other (Specify below)
 2 Irrigation 4 Industrial 7 Domestic (lawn & garden) 10 Monitoring well

Was a chemical/bacteriological sample submitted to Department? Yes No X; If yes, mo/day/yr sample was submitted
 Water Well Disinfected? Yes No

5 TYPE OF BLANK CASING USED:
 1 Steel 3 RMP (SR)
 2 PVC 4 ABS
 5 Wrought iron 8 Concrete tile CASING JOINTS: Glued X Clamped
 6 Asbestos-Cement 9 Other (specify below) Welded
 7 Fiberglass Threaded

Blank casing diameter: 5 in. to 10 ft., Dia in. to ft.
 Casing height above land surface: 18 in., weight lbs./ft. Wall thickness or gauge No. SDR-26

TYPE OF SCREEN OR PERFORATION MATERIAL:
 1 Steel 3 Stainless Steel 5 Fiberglass 7 PVC 10 Asbestos-Cement
 2 Brass 4 Galvanized Steel 6 Concrete tile 8 RMP (SR) 11 Other (Specify)
 12 None used (open hole)

SCREEN OR PERFORATION OPENINGS ARE:
 1 Continuous slot 3 Mill slot 5 Gauzed wrapped 8 Saw cut 11 None (open hole)
 2 Louvered shutter 4 Key punched 6 Wire wrapped 9 Drilled holes
 7 Torch cut 10 Other (specify)

SCREEN-PERFORATED INTERVALS: From 40 ft. to 71 ft., From ft. to ft.
 GRAVEL PACK INTERVALS: From NONE ft. to (PACKER) ft., From ft. to ft.

6 GROUT MATERIAL: 1 Neat cement 2 Cement grout 3 Bentonite 4 Other
 Grout Intervals: From 3 ft. to 23 ft., From ft. to ft.

What is the nearest source of possible contamination:
 1 Septic tank 4 Lateral lines 7 Pit privy 10 Livestock pens 14 Abandoned water well
 2 Sewer lines 5 Cess pool 8 Sewage lagoon 11 Fuel storage 15 Oil well/Gas well
 3 Watertight sewer lines 6 Seepage pit 9 Feedyard 12 Fertilizer storage 16 Other (specify below)
 13 Insecticide storage

Direction from well? North How many feet? 60

| FROM | TO | LITHOLOGIC LOG | FROM | TO | PLUGGING INTERVALS |
|------|----|--------------------------|------|----|--------------------|
| 0 | 3 | Aluvium | | | |
| 3 | 17 | LIME - Lite TAN & Flint | | | |
| 17 | 18 | Shale Yel (soft) | | | |
| 18 | 24 | LIME - Yel | | | |
| 24 | 41 | Shale - Yel-Green-Red | | | |
| 41 | 43 | LIME - Frac & Exten Soft | | | |
| 43 | 45 | LIME - Solid TAN | | | |
| 45 | 58 | Shale - Gray | | | |
| 58 | 63 | LIME TAN | | | |
| 63 | 65 | Shale Gray | | | |
| 65 | 71 | LIME Hard | | | |

7 CONTRACTOR'S OR LANDOWNER'S CERTIFICATION: This water well was (1) constructed, (2) reconstructed, or (3) plugged under my jurisdiction and was completed on (mo/day/year) Sep 30 - 05 and this record is true to the best of my knowledge and belief. Kansas Water Well Contractor's Licence No 218 This Water Well Record was completed on (mo/day/yr) Oct 2 05 under the business name of ZINN Water Well Dring. by (signature) Joseph A. Zinn