


03-70

1 LOCATION OF WATER WELL: County: **ELLISWORTH** Fraction: **NE 1/4 SW 1/4 SW 1/4** Section Number: **30** Township Number: **T 17 S** Range Number: **R 10 E (W)**

Distance and direction from nearest town or city street address of well if located within city?  
**7777 AVE. Y**

2 WATER WELL OWNER: **KN PROCESSING, INC.**  
RR#, St. Address, Box #: **R.R. 1 BOX 5A** Board of Agriculture, Division of Water Resources  
City, State, ZIP Code: **BUSHTON, KANSAS 67427** Application Number:

3 LOCATE WELL'S LOCATION WITH AN "X" IN SECTION BOX: 4 DEPTH OF COMPLETED WELL: **15** ft. ELEVATION:

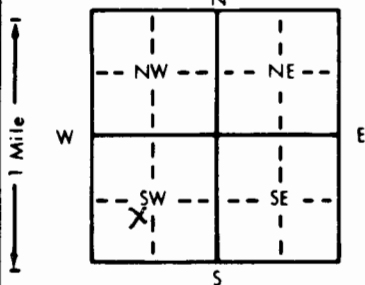

Depth(s) Groundwater Encountered 1. .... ft. 2. .... ft. 3. .... ft.  
WELL'S STATIC WATER LEVEL ..... ft. below land surface measured on mo/day/yr  
Pump test data: Well water was ..... ft. after ..... hours pumping ..... gpm  
Est. Yield ..... gpm: Well water was ..... ft. after ..... hours pumping ..... gpm  
Bore Hole Diameter: **7.14** in. to **15** ft., and ..... in. to ..... ft.  
WELL WATER TO BE USED AS: 5 Public water supply 8 Air conditioning 11 Injection well  
1 Domestic 3 Feedlot 6 Oil field water supply 9 Dewatering 12 Other (Specify below)  
2 Irrigation 4 Industrial 7 Lawn and garden only  Monitoring well  
Was a chemical/bacteriological sample submitted to Department? Yes..... No.....; If yes, mo/day/yr sample was submitted  
Water Well Disinfected? Yes No

5 TYPE OF BLANK CASING USED: 5 Wrought iron 8 Concrete tile CASING JOINTS: Glued ..... Clamped .....  
1 Steel 3 RMP (SR) 6 Asbestos-Cement 9 Other (specify below) Welded .....  
 PVC 4 ABS 7 Fiberglass Threaded.....

Blank casing diameter ..... **2** in. to **10** ft., Dia ..... in. to ..... ft., Dia ..... in. to ..... ft.  
Casing height above land surface: **32** in., weight **Schil 40** lbs./ft. Wall thickness or gauge No. ....

TYPE OF SCREEN OR PERFORATION MATERIAL:  PVC 10 Asbestos-cement  
1 Steel 3 Stainless steel 5 Fiberglass 8 RMP (SR) 11 Other (specify) .....  
2 Brass 4 Galvanized steel 6 Concrete tile 9 ABS 12 None used (open hole)

SCREEN OR PERFORATION OPENINGS ARE: 5 Gauzed wrapped 8 Saw cut 11 None (open hole)  
1 Continuous slot  Mill slot 6 Wire wrapped 9 Drilled holes  
2 Louvered shutter 4 Key punched 7 Torch cut 10 Other (specify) .....

SCREEN-PERFORATED INTERVALS: From **15** ft. to **5** ft., From ..... ft. to ..... ft.  
From ..... ft. to ..... ft., From ..... ft. to ..... ft.  
GRAVEL PACK INTERVALS: From **15** ft. to **3.5** ft., From ..... ft. to ..... ft.  
From ..... ft. to ..... ft., From ..... ft. to ..... ft.

6 GROUT MATERIAL: 1 Neat cement 2 Cement grout  Bentonite 4 Other .....  
Grout Intervals: From ..... ft. to ..... ft., From **3.5** ft. to **0** ft., From ..... ft. to ..... ft.

What is the nearest source of possible contamination:  
1 Septic tank 4 Lateral lines 7 Pit privy 10 Livestock pens 14 Abandoned water well  
2 Sewer lines 5 Cess pool 8 Sewage lagoon 11 Fuel storage 15 Oil well/Gas well  
3 Watertight sewer lines 6 Seepage pit 9 Feedyard 12 Fertilizer storage 16 Other (specify below)  
13 Insecticide storage  
Direction from well? **SE** How many feet? **1100'**

FROM	TO	LITHOLOGIC LOG	FROM	TO	PLUGGING INTERVALS
0	1	Silty SAND, dk brn			
1	7	Silty CLAY, dk brn			
7	10	CLAYEY SAND, yellowish brn			
10	11	Silty SAND, dk grayish brn			
11	13.5	AS ABOVE			
13.5	15	SANDY CLAY, dk GRAY			

7 CONTRACTOR'S OR LANDOWNER'S CERTIFICATION: This water well was  constructed, (2) reconstructed, or (3) plugged under my jurisdiction and was completed on (mo/day/year) **6-18-97** and this record is true to the best of my knowledge and belief. Kansas Water Well Contractor's License No. **575** This Water Well Record was completed on (mo/day/yr) **6-18-97** under the business name of **KURT ENVIRONMENTAL SERVICE** by (signature) *[Signature]*

OFFICE USE ONLY