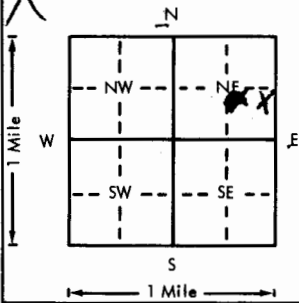


USE TYPEWRITER OR BALL  
POINT PEN-PRESS FIRMLY,  
PRINT CLEARLY.

WATER WELL RECORD  
KSA 82a-1201-1215

Kansas Department of Health and  
Environment-Division of Environment  
(Water well Contractors)  
Topeka, Kansas 66620

*Frohreich #1*

1. Location of well:	County <i>Ellsworth</i>	Section <i>NE 1/4 SE 1/4 NE 1/4</i>	Section number <i>17</i>	Township number <i>T 17 S</i>	Range number <i>R 10 W</i>
2. Distance and direction from nearest town or city: <i>3 west 3</i>		3. Owner of well: <i>Duke Drilling Co</i>			
Street address of well location if in city: <i>South Hollywood</i>		R.R. or street: <i>Great Bend Ks</i>			
City, state, zip code:					
X Locate with "X" in section below:		Sketch map:		6. Bore hole dia. <i>7</i> in. Completion date <i>11-12-75</i>	
				Well depth <i>190</i> ft.	
5. Type and color of material		From	To	7. Cable tool <input checked="" type="checkbox"/> Rotary <input type="checkbox"/> Driven <input type="checkbox"/> Dug	
<i>Clay</i>		<i>0</i>	<i>100</i>	<input type="checkbox"/> Hollow rod <input type="checkbox"/> Jetted <input type="checkbox"/> Bored <input type="checkbox"/> Reverse rotary	
<i>Blue shale</i>		<i>100</i>	<i>150</i>	8. Use: <input type="checkbox"/> Domestic <input type="checkbox"/> Public supply <input type="checkbox"/> Industry	
<i>yellow Rock</i>		<i>150</i>	<i>120</i>	<input type="checkbox"/> Irrigation <input type="checkbox"/> Air conditioning <input type="checkbox"/> Stock	
<i>Sand Rock</i>		<i>170</i>	<i>190</i>	<input type="checkbox"/> Lawn <input checked="" type="checkbox"/> Oil field water <input type="checkbox"/> Other	
				9. Casing: Material <i>Plastic</i> Height: <i>Above</i> or below	
				Threaded <input type="checkbox"/> Welded <input checked="" type="checkbox"/> Surface <i>12</i> in.	
				RMP <input type="checkbox"/> PVC <input checked="" type="checkbox"/> Weight <i>18.3</i> lbs./ft.	
				Dia. <i>4</i> in. to <i>190</i> ft. depth Wall Thickness: inches or	
				Dia. <input type="checkbox"/> in. to <input type="checkbox"/> ft. depth gage No. <i>200</i>	
				10. Screen: Manufacturer's name <i>Pearless Plastic</i>	
				Type <i>PVC</i> Dia. <i>4</i>	
				Slot gauge <i>1/8</i> Length <i>20</i>	
				Set between <i>170</i> ft. and <i>190</i> ft.	
				<input type="checkbox"/> ft. and <input type="checkbox"/> ft.	
				Gravel pack? <input checked="" type="checkbox"/> Size range of material <i>1/8 1/4</i>	
				11. Static water level: <i>75</i> ft. below land surface Date <i>11-12-75</i>	
				mo./day/yr. <i>11-12-75</i>	
				12. Pumping level below land surfaces: <i>120</i>	
				<input type="checkbox"/> ft. after <input type="checkbox"/> hrs. pumping <input type="checkbox"/> g.p.m.	
				<input type="checkbox"/> ft. after <input type="checkbox"/> hrs. pumping <input type="checkbox"/> g.p.m.	
				Estimated maximum yield <input type="checkbox"/> g.p.m.	
				13. Water sample submitted: <i>12</i> mo./day/yr.	
				Yes <input checked="" type="checkbox"/> No <input type="checkbox"/> Date <i>12</i>	
				14. Well head completion: <i>12</i> inches above grade	
				<input type="checkbox"/> Pitless adapter <input checked="" type="checkbox"/> <i>12</i> inches above grade	
				15. Well grouted? <i>yes</i>	
				With: <input type="checkbox"/> Neat cement <input checked="" type="checkbox"/> Bentonite <input type="checkbox"/> Concrete	
				Depth: From <i>0</i> ft. to <i>10</i> ft.	
				16. Nearest source of possible contamination: <i>None</i>	
				ft. <input type="checkbox"/> Direction <input type="checkbox"/> Type <input type="checkbox"/>	
				Well disinfected upon completion? <input type="checkbox"/> Yes <input type="checkbox"/> No	
				17. Pump: <input checked="" type="checkbox"/> Not installed	
				Manufacturer's name <input type="checkbox"/>	
				Model number <input type="checkbox"/> HP <input type="checkbox"/> Volts <input type="checkbox"/>	
				Length of drop pipe <input type="checkbox"/> ft. capacity <input type="checkbox"/> g.p.m.	
				Type: <input type="checkbox"/> Submersible <input type="checkbox"/> Turbine	
				<input type="checkbox"/> Jet <input type="checkbox"/> Reciprocating	
				<input type="checkbox"/> Centrifugal <input type="checkbox"/> Other	
18. Elevation:		19. Remarks:			
Topography: <input type="checkbox"/> Hill <input checked="" type="checkbox"/> Slope <input type="checkbox"/> Upland <input type="checkbox"/> Valley					
		20. Water well contractor's certification: This well was drilled under my jurisdiction and this report is true to the best of my knowledge and belief. <i>Myers Water Well 1143</i> Business name <i>Myers Water Well 1143</i> License No. <i>1143</i> Address <i>Great Bend Ks</i> Signed <i>Myers Water Well 1143</i> 11-12-75 Authorized representative			

Forward the white, blue and pink copies to the Department of Health and Environment

Form WWC-5