


1 LOCATION OF WATER WELL: County: <u>Ellsworth</u>	Fraction: <u>NE 1/4 NE 1/4 SW 1/4</u>	Section Number: <u>33</u>	Township Number: <u>T 12 S</u>	Range Number: <u>R 10 E</u>
---	---------------------------------------	---------------------------	--------------------------------	-----------------------------

Distance and direction from nearest town or city, street address of well if located within city?

4 miles East + 1/2 North of Clatlin, KS

2 WATER WELL OWNER: <u>William Stumps Red Tiger Drilling Co</u> RR#, St. Address, Box #: <u>RFD</u> City, State, ZIP Code: <u>Bushlan, KS</u> } <u>1730 N. St. Bank Bldg</u> <u>Wichita, KS 67202</u>	Board of Agriculture, Division of Water Resources Application Number: <u>900064</u>
--	--

3 LOCATE WELL'S LOCATION WITH AN "X" IN SECTION BOX:	4 DEPTH OF COMPLETED WELL: <u>12.7</u> ft. ELEVATION:
--	---

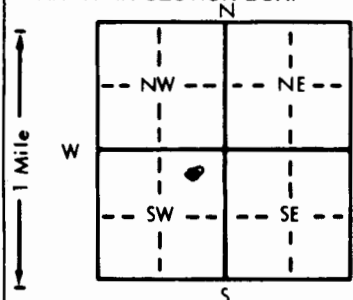

Depth(s) Groundwater Encountered: 1. <u>35</u> ft. 2. <u>3-2-90</u> ft. 3. <u>3-2-90</u> ft.
WELL'S STATIC WATER LEVEL: <u>35</u> ft. below land surface measured on mo/day/yr
Pump test data: Well water was _____ ft. after _____ hours pumping _____ gpm
Est. Yield _____ gpm: Well water was _____ ft. after _____ hours pumping _____ gpm
Bore Hole Diameter: <u>12.7</u> in. to _____ ft., and _____ in. to _____ ft.
WELL WATER TO BE USED AS:
1 Domestic 3 Feedlot 5 Public water supply 8 Air conditioning 11 Injection well
2 Irrigation 4 Industrial 6 Oil field water supply 9 Dewatering 12 Other (Specify below)
7 Lawn and garden only 10 Monitoring well
Was a chemical/bacteriological sample submitted to Department? Yes _____ No <u>X</u> ; If yes, mo/day/yr sample was submitted _____
Water Well Disinfected? Yes _____ No <u>X</u>

5 TYPE OF BLANK CASING USED:	5 Wrought iron	8 Concrete tile	CASING JOINTS: Glued <u>X</u> Clamped _____
1 Steel	6 Asbestos-Cement	9 Other (specify below)	Welded _____
2 PVC	7 Fiberglass		Threaded _____
3 RMP (SR)			
4 ABS			
Blank casing diameter: <u>5</u> in. to _____ ft., Dia _____ in. to _____ ft., Dia _____ in. to _____ ft.			
Casing height above land surface: <u>3' below</u> in., weight _____ lbs./ft. Wall thickness or gauge No. _____			
TYPE OF SCREEN OR PERFORATION MATERIAL:	5 Fiberglass	8 RMP (SR)	10 Asbestos-cement
1 Steel	6 Concrete tile	9 ABS	11 Other (specify) _____
2 Brass			12 None used (open hole)
3 Stainless steel			
4 Galvanized steel			
SCREEN OR PERFORATION OPENINGS ARE:	5 Gauzed wrapped	8 Saw cut	11 None (open hole)
1 Continuous slot	6 Wire wrapped	9 Drilled holes	
2 Louvered shutter	7 Torch cut	10 Other (specify) _____	
3 Mill slot			
4 Key punched			
SCREEN-PERFORATED INTERVALS: From _____ ft. to _____ ft., From _____ ft. to _____ ft., From _____ ft. to _____ ft.			
GRAVEL PACK INTERVALS: From _____ ft. to _____ ft., From _____ ft. to _____ ft., From _____ ft. to _____ ft.			

6 GROUT MATERIAL:	1 Neat cement	2 Cement grout	3 Bentonite	4 Other _____
Grout Intervals: From <u>3</u> ft. to <u>12.7</u> ft., From _____ ft. to _____ ft., From _____ ft. to _____ ft.				
What is the nearest source of possible contamination:	1 Septic tank	4 Lateral lines	7 Pit privy	10 Livestock pens
	2 Sewer lines	5 Cess pool	8 Sewage lagoon	11 Fuel storage
	3 Watertight sewer lines	6 Seepage pit	9 Feedyard	12 Fertilizer storage
				13 Insecticide storage
				14 Abandoned water well
				15 Oil well/Gas well
				16 Other (specify below)
				<u>120' NE</u>
Direction from well?				How many feet?

FROM	TO	LITHOLOGIC LOG	FROM	TO	PLUGGING INTERVALS
<u>3'</u>	<u>12.7</u>	<u>Cement</u>			
<u>0</u>	<u>3'</u>	<u>Soil</u>			
		<u>Filled entire well with Cement</u>			
		<u>Cut casing off 3' below ground level</u>			
		<u>Filled with surface silt from 3' below to ground level</u>			

7 CONTRACTOR'S OR LANDOWNER'S CERTIFICATION: This water well was (1) constructed, (2) reconstructed, or (3) plugged under my jurisdiction and was completed on (mo/day/year) <u>3-2-90</u> and this record is true to the best of my knowledge and belief. Kansas Water Well Contractor's License No. _____ This Water Well Record was completed on (mo/day/yr) <u>3-2-90</u> under the business name of <u>Red Tiger Drilling Co</u> by (signature) <u>Clayton Engel</u>
