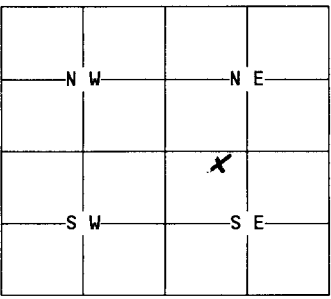


1	LOCATION OF WATER WELL: County: <u>Barton</u>	Fraction <u>NE 1/4 NW 1/4 SE 1/4</u>	Section Number <u>8</u>	Township Number <u>17 S</u>	Range Number <u>11 W</u>
---	--	---	----------------------------	--------------------------------	-----------------------------

Distance and direction from nearest town or city street address of well if located within city?
Clafflin, Ks. 3 K-4 Hwy 4 mi North 1 1/2 West North into

2	WATER WELL OWNER: <u>Tracy Hynes</u>	RR#, St. Address, Box #: <u>5949 West Cloud St.</u>	Board of Agriculture, Division of Water Resources
	City, State, ZIP Code: <u>Salina, Ks, 67401</u>		Application Number:

3	MARK WELL'S LOCATION WITH AN "X" IN SECTION BOX: N  S	4	DEPTH OF WELL..... <u>160</u>ft. WELL'S STATIC WATER LEVEL.... <u>45</u>ft. WELL WAS USED AS: 1 Domestic 2 Irrigation 3 Feedlot 4 Industrial 5 Public Water Supply 6 <input checked="" type="checkbox"/> Oil Field Water Supply 7 Lawn and Garden Only 8 Air Conditioning 9 Dewatering 10 Monitoring Well 11 Injection Well 12 Other..... Was a chemical/bacteriological sample submitted to Department? Yes....No <input checked="" type="checkbox"/> If yes, mo/day/yr sample was submitted..... Water Well Disinfected: Yes <input checked="" type="checkbox"/> No.....
---	--	---	---

5	TYPE OF BLANK CASING USED: 1 Steel <input checked="" type="checkbox"/> PVC 3 RMP (SR) 4 ABS 5 Wrought 6 Asbestos-Cement 7 Fiberglass 8 Concrete Tile 9 Other (specify below) Blank casing diameter... <u>5</u>in. Was casing pulled? Yes <input checked="" type="checkbox"/> No..... If yes, how much... <u>12'</u> Casing height above or <u>below</u> land surface..... <u>1.44</u>in.
---	---

6	GROUT PLUG MATERIAL: 1 Neat cement 2 Cement grout <input checked="" type="radio"/> Bentonite 4 Other..... Grout Plug Intervals: From... <u>45</u> ...ft. to... <u>12</u> ...ft., From.....ft. to.....ft., From..... to.....ft. What is the nearest source of possible contamination: 1 Septic tank 2 Sewer lines 3 Watertight sewer lines 4 Lateral lines 5 Cess Pool 6 Seepage pit 7 Pit privy 8 Sewage lagoon 9 Feedyard 10 Livestock pens 11 Fuel storage 12 Fertilizer storage 13 Insecticide storage 14 Abandoned water well 15 Oil well/Gas well 16 Other (specify below) <u>Plugged oil well</u> Direction from well? ... <u>SW</u> How many feet? ... <u>75'</u>
---	---

FROM	TO	PLUGGING MATERIALS
<u>160</u>	<u>45</u>	<u>Disintegrated Sand 15.64 Cu. Ft</u>
<u>45</u>	<u>12</u>	<u>3/8 Hole Plug Bentonite 4.49 Cu. Ft</u>
<u>12</u>	<u>0</u>	<u>Native Clays</u>

7	CONTRACTOR'S OR LANDOWNER'S CERTIFICATION: This water well was plugged under my jurisdiction and was completed on (mo/day/year)... <u>10-10-01</u> and this record is true to the best of my knowledge and belief. Kansas Water Well Contractor's License No. ... <u>660</u> This Water Well Record was completed on (mo/day/year) ... <u>10-10-01</u> under the business name of ... <u>Goodman Water Well Co.</u> ... by (signature) <u>John Goodman</u>
---	--

INSTRUCTIONS: Use typewriter or ball point pen. Please press firmly and print clearly. Please fill in blanks, underline or circle the correct answers. Send top three copies to Kansas Department of Health and Environment, Bureau of Water, Topeka, Kansas 66620-0001. Telephone: 913/296-3565. Send one to Water Well Owner and retain one for your records.