


1 LOCATION OF WATER WELL: Fraction 1/4 NW 1/4 NW 1/4 NE Section Number 29 Township Number 17 Range Number 11 County: Barton E/W

Distance and direction from nearest town or city street address of well if located within city?

2 WATER WELL OWNER: Marie M. Huslig
 RR #, St. Address, Box #: 1171 NE 130 Rd
 City, State, ZIP Code: Claffin ks 67525
 Board of Agriculture, Division of Water Resources
 Application Number:

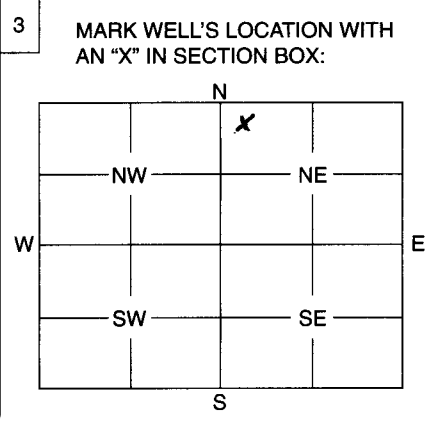

4 DEPTH OF WELL 57 ft.
 WELL'S STATIC WATER LEVEL 45 ft.
 WELL WAS USED AS:

1 Domestic	5 Public Water Supply	9 Dewatering
2 Irrigation	6 Oil Field Water Supply	10 Monitoring Well
3 Feedlot	<input checked="" type="checkbox"/> Domestic (Lawn & Garden)	11 Injection Well
4 Industrial	8 Air Conditioning	12 Other

Was a chemical / bacteriological sample submitted to Department? Yes No
 If yes, mo/day/yr sample was submitted

Water Well Disinfected: Yes No

5 TYPE OF BLANK CASING USED:

<input checked="" type="checkbox"/> Steel	3 RMP (SR)	5 Wrought	7 Fiberglass	9 Other (Specify below)
2 PVC	4 ABS	6 Asbestos-Cement	8 Concrete Tile	

Blank casing diameter 5 in. Was casing pulled? Yes No If yes, how much 55'
 Casing height above or below land surface in.

6 GROUT PLUG MATERIAL: 1 Neat cement 2 Cement grout Bentonite 4 Other

Grout Plug Intervals: From 0 ft. to 45 ft., From ft. to ft., From to ft.

What is the nearest source of possible contamination:

1 Septic tank	6 Seepage pit	11 Fuel storage	16 Other (specify below)
2 Sewer lines	7 Pit privy	12 Fertilizer storage	
3 Watertight sewer lines	8 Sewage lagoon	13 Insecticide storage	
4 Lateral lines	9 Feedyard	14 Abandoned water well	
5 Cess pool	<input checked="" type="checkbox"/> Livestock pens	15 Oil well/Gas well	

Direction from well? West How many feet? 10'

FROM	TO	PLUGGING MATERIALS
<u>45</u>	<u>57</u>	<u>Disinfected Sand 1.38 ct</u>
<u>0</u>	<u>45</u>	<u>Bentonite Hole plug 6.82 ct</u>

7 CONTRACTOR'S OF LANDOWNER'S CERTIFICATION: This water well was plugged under my jurisdiction and was completed on (mo/day/year) 7-23-03 and this record is true to the best of my knowledge and belief. Kansas Water Well Contractor's License No. 660 This Water Well Record was completed on (mo/day/year) under the business name of Goodman Water Well Drllg. by (signature) Jim Goodman

INSTRUCTIONS: Use typewriter or ball point pen. Please press firmly and print clearly. Please fill in blanks, underline or circle the correct answers. Send top three copies to Kansas Department of Health and Environment, Bureau of Water, Geology Section, 1000 SW Jackson St., Ste. 420, Topeka, Kansas 66612-1367. Telephone: 785/296-5522. Send one to Water Well Owner and retain one for your records.