


1 LOCATION OF WATER WELL: Fraction Section Number Township Number Range Number  
 County: Barton NW 1/4 NW 1/4 NE 1/4 29 17 11 **EM**

Distance and direction from nearest town or city street address of well if located within city?

2 WATER WELL OWNER: Marie M. Huslig  
 RR #, St. Address, Box #: 1171 NE 130 RD  
 City, State, ZIP Code: Cladonia KS 67335  
 Board of Agriculture, Division of Water Resources  
 Application Number: \_\_\_\_\_

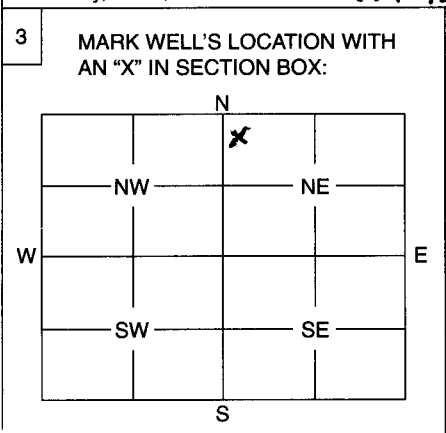

4 DEPTH OF WELL ..... 45 ..... ft.  
 WELL'S STATIC WATER LEVEL ..... 5 ..... ft.  
 WELL WAS USED AS:  
 1 Domestic                      5 Public Water Supply                      9 Dewatering  
 2 Irrigation                      6 Oil Field Water Supply                      10 Monitoring Well  
 3 Feedlot                       8 Domestic (Lawn & Garden)                      11 Injection Well  
 4 Industrial                      8 Air Conditioning                      12 Other .....

Was a chemical / bacteriological sample submitted to Department? Yes  No   
 If yes, mo/day/yr sample was submitted .....

Water Well Disinfected: Yes  No .....

5 TYPE OF BLANK CASING USED:  
 1 Steel      3 RMP (SR)      5 Wrought      7 Fiberglass      9 Other (Specify below)  
 2 PVC      4 ABS      6 Asbestos-Cement      8 Concrete Tile .....

Blank casing diameter ..... 5 ..... in.      Was casing pulled?      Yes       No .....      If yes, how much ..... 45' .....  
 Casing height above or below land surface ..... 60 ..... in.      Casing was pulled Soil 60" Deep

6 GROUT PLUG MATERIAL:      1 Neat cement      2 Cement grout      3 Bentonite      4 Other .....

Grout Plug Intervals:      From ..... 5 ..... ft.      to ..... 40 ..... ft.,      From ..... ft.      to ..... ft.,      From ..... ft.      to ..... ft.

What is the nearest source of possible contamination:

1 Septic tank	6 Seepage pit	11 Fuel storage	16 Other (specify below)
2 Sewer lines	7 Pit privy	12 Fertilizer storage	.....
3 Watertight sewer lines	8 Sewage lagoon	13 Insecticide storage	
4 Lateral lines	9 Feedyard	14 Abandoned water well	
5 Cess pool	10 Livestock pens	15 Oil well/Gas well	

Direction from well? .....      How many feet? .....

FROM	TO	PLUGGING MATERIALS
<u>45</u>	<u>40</u>	<u>Sand Disinfected .662 ct</u>
<u>40</u>	<u>5</u>	<u>Bentonite Hole Plug 5.46 ct</u>
<u>5</u>	<u>0</u>	<u>Soil .629 ct</u>

7 CONTRACTOR'S OF LANDOWNER'S CERTIFICATION: This water well was plugged under my jurisdiction and was completed on (mo/day/year) ..... 7-23-03 ..... and this record is true to the best of my knowledge and belief. Kansas Water Well Contractor's License No. .... 660 ..... This Water Well Record was completed on (mo/day/year) ..... under the business name of ..... Goodman Water Well Drilling ..... by (signature) ..... Just Good .....

INSTRUCTIONS: Use typewriter or ball point pen. Please press firmly and print clearly. Please fill in blanks, underline or circle the correct answers. Send top three copies to Kansas Department of Health and Environment, Bureau of Water, Geology Section, 1000 SW Jackson St., Ste. 420, Topeka, Kansas 66612-1367. Telephone: 785/296-5522. Send one to Water Well Owner and retain one for your records.