


☒ Original Record ☐ Correction ☐ Change in Well Use

ESMW-1

Well ID

KS Department of Health and Environment, Bureau of Water, Geology Section, 1000 SW Jackson St., Suite 420, Topeka, Kansas 66612-1367. Telephone 785-296-3565.
Visit us at <http://www.kdheks.gov/waterwell/index.html> KSA 82a-1212

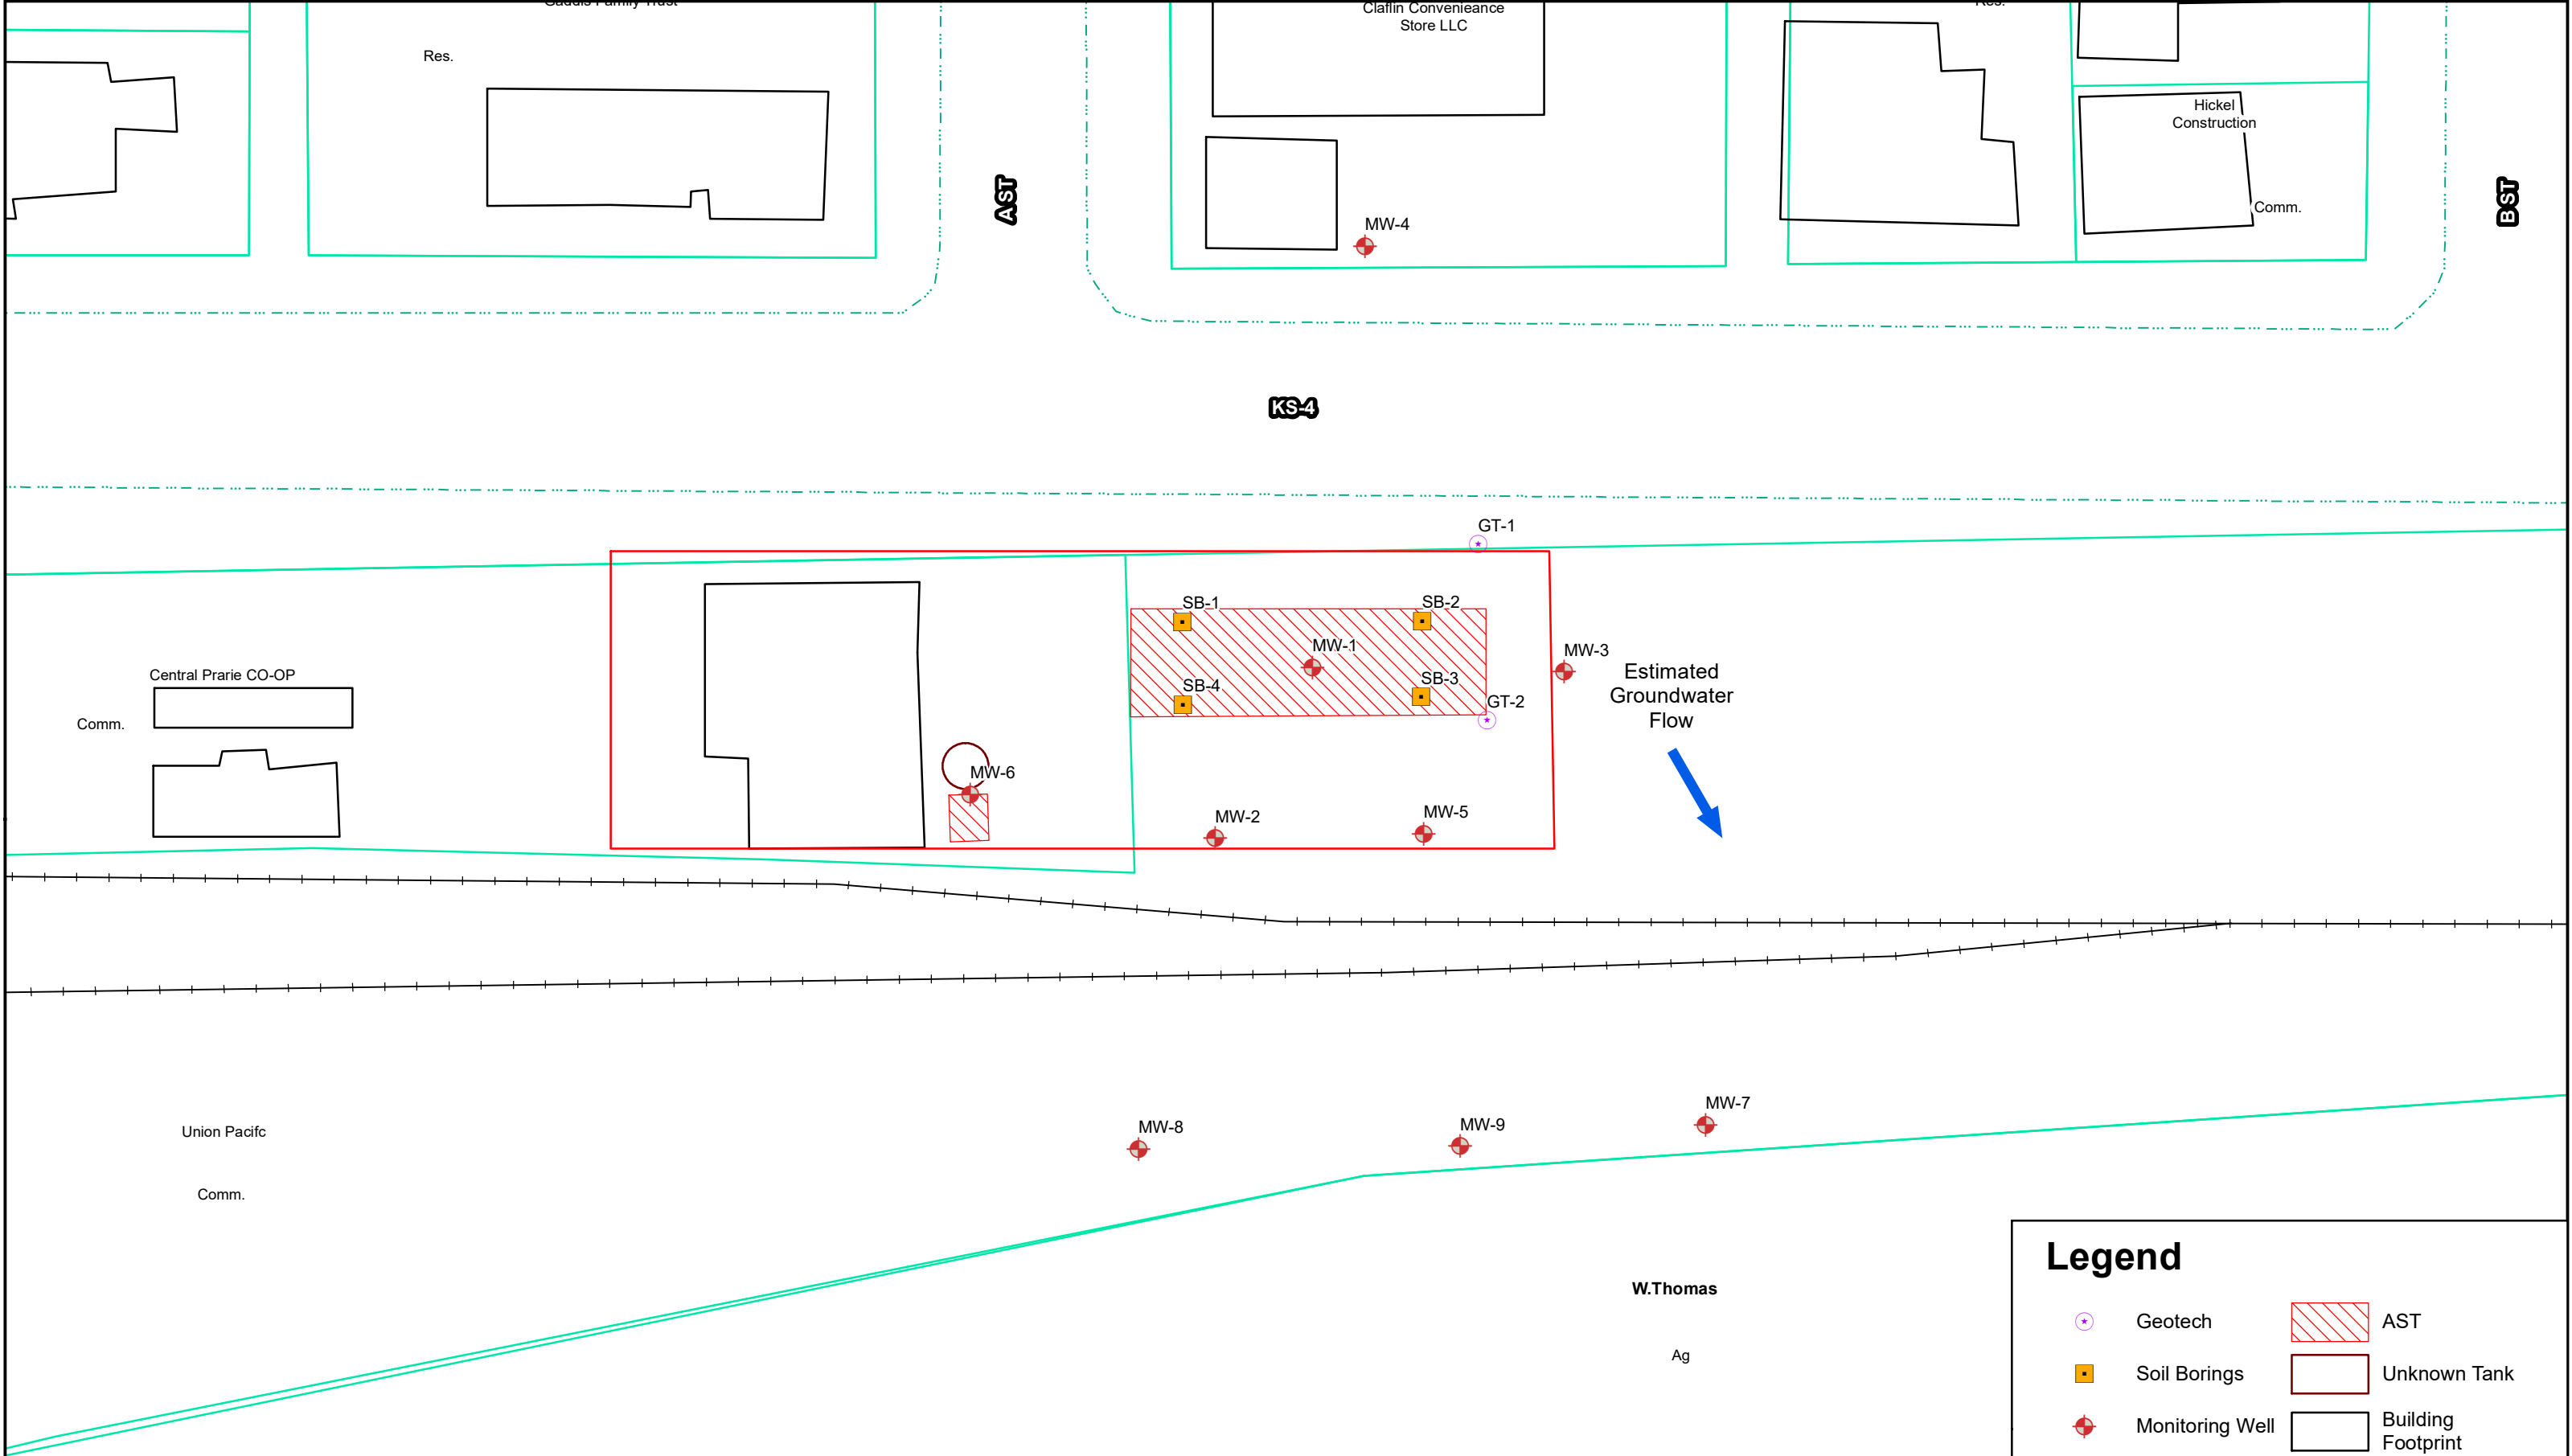

Legend

	Geotech		AST
	Soil Borings		Unknown Tank
	Monitoring Well		Building Footprint
	Easement		Parcels
	Railroad		Site Boundary

PRODUCT LINE LOCATIONS UNKNOWN
ALL BOUNDARIES AND LOCATIONS ARE APPROXIMATE



FIGURE:	2.0	FIGURE NAME:	Site Base Map
DATE:	4/26/20	PROJECT NUMBER:	1974116
DRAWN BY:	CN	PROJECT MANAGER:	A. Chadd

Essmiller Oil Co.
Claflin, KS
KDHE#: A6-005-40491

