


☒ Original Record ☐ Correction ☐ Change in Well Use

ESMW-2

Well ID

[illegible]

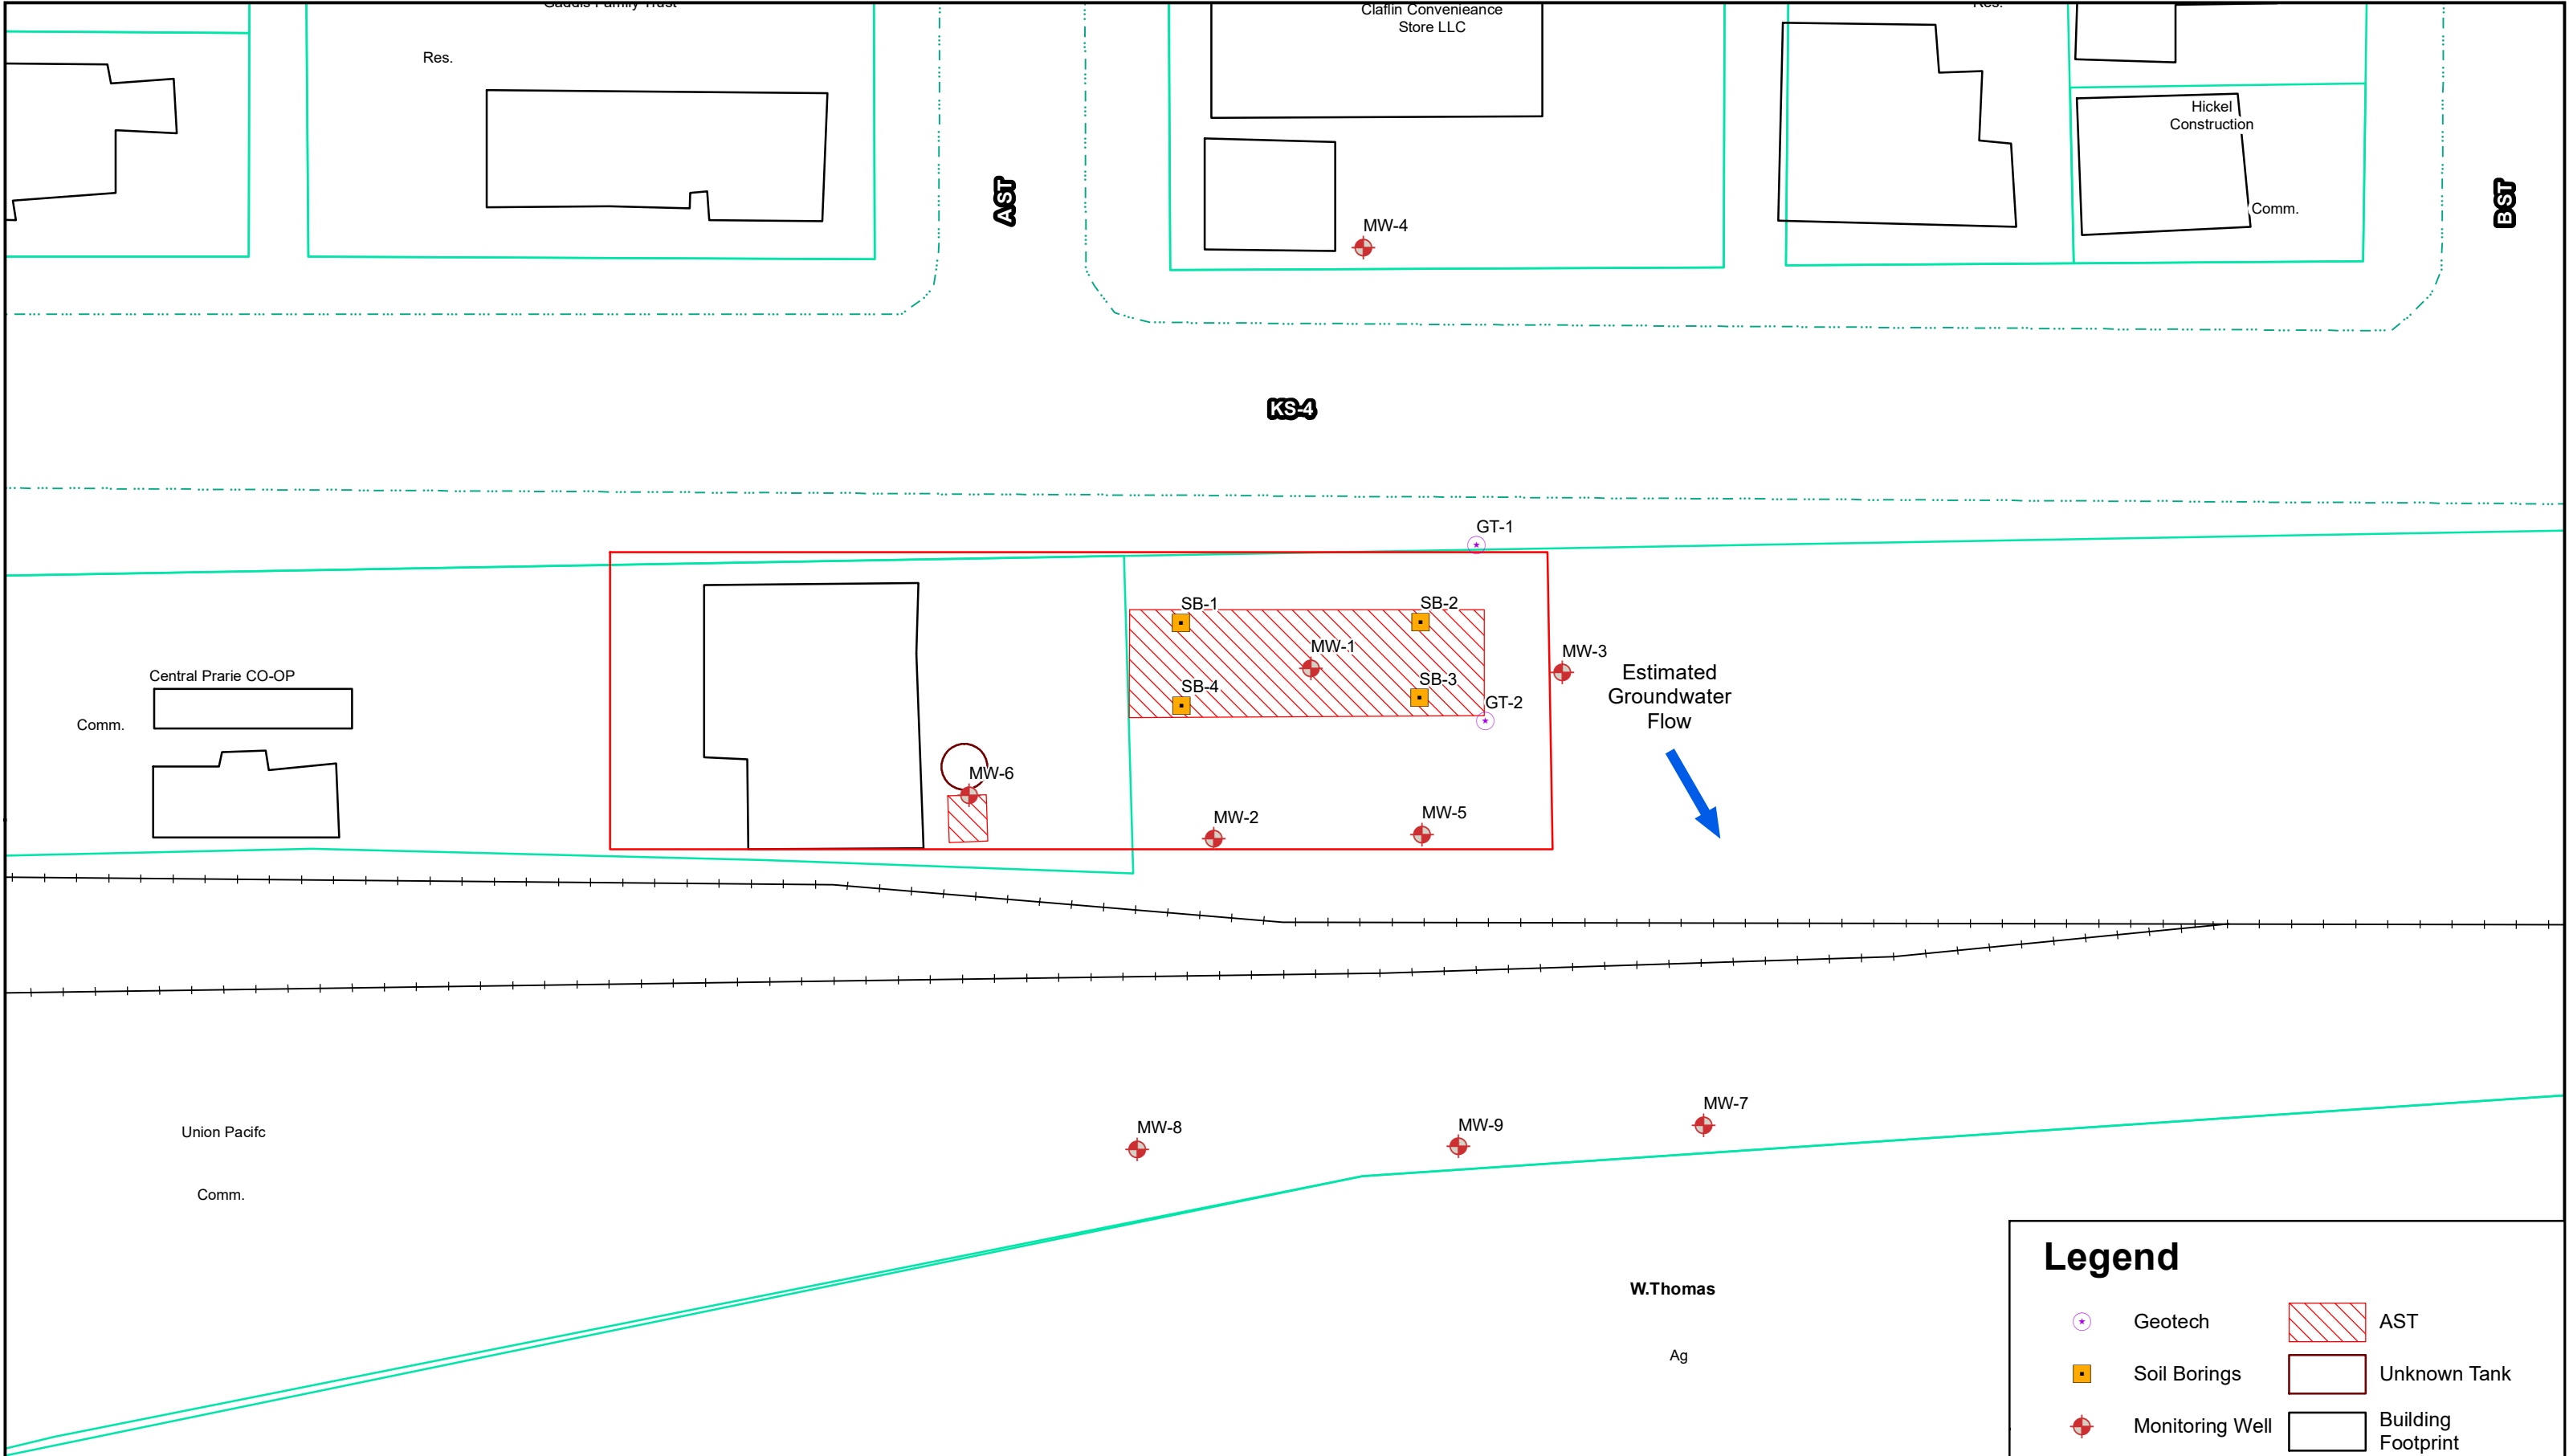

Legend

	Geotech		AST
	Soil Borings		Unknown Tank
	Monitoring Well		Building Footprint
	Easement		Parcels
	Railroad		Site Boundary

PRODUCT LINE LOCATIONS UNKNOWN
ALL BOUNDARIES AND LOCATIONS ARE APPROXIMATE



FIGURE:	2.0	FIGURE NAME:	Site Base Map
DATE:	4/26/20	PROJECT NUMBER:	1974116
DRAWN BY:	CN	PROJECT MANAGER:	A. Chadd

Essmiller Oil Co.
Claflin, KS
KDHE#: A6-005-40491

