


☒ Original Record ☐ Correction ☐ Change in Well Use

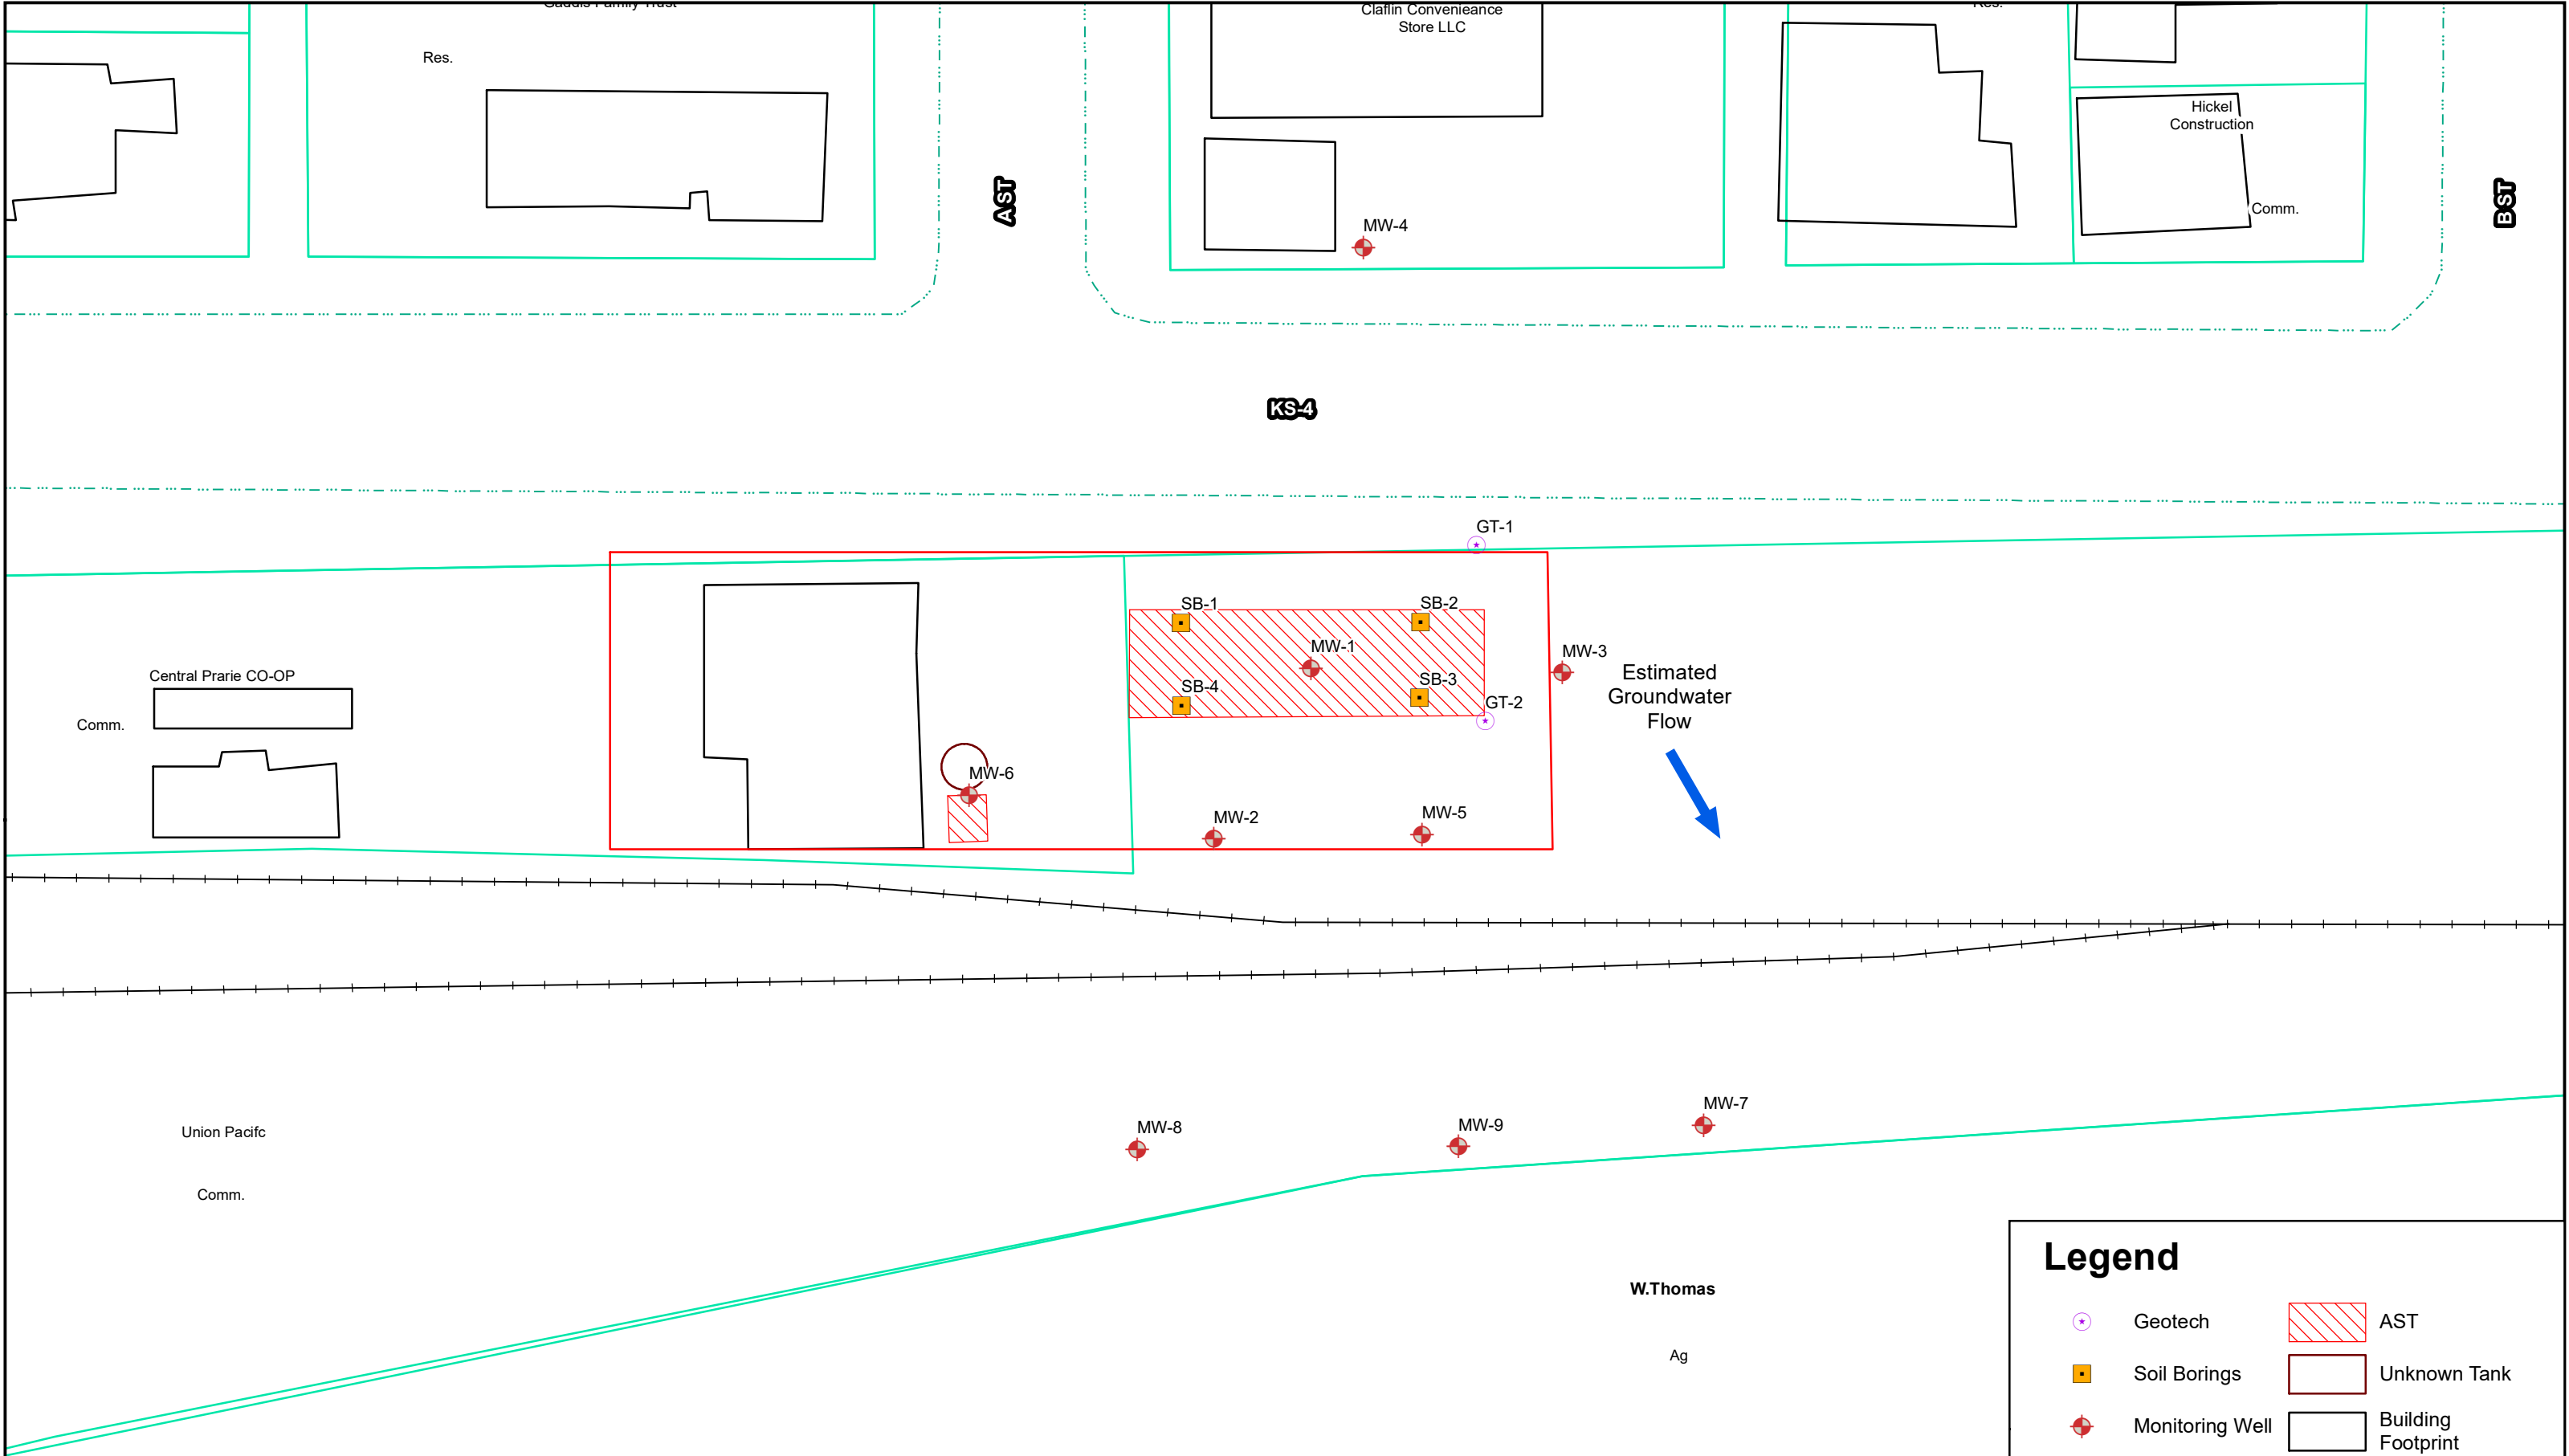








ESMW-3

Well ID

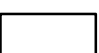

[illegible]



Legend

- | | | | |
|---|-----------------|---|--------------------|
|  | Geotech |  | AST |
|  | Soil Borings |  | Unknown Tank |
|  | Monitoring Well |  | Building Footprint |
|  | Easement |  | Parcels |
|  | Railroad |  | Site Boundary |

PRODUCT LINE LOCATIONS UNKNOWN
ALL BOUNDARIES AND LOCATIONS ARE APPROXIMATE

	FIGURE: 2.0	FIGURE NAME: Site Base Map	Essmiller Oil Co. Claflin, KS KDHE#: A6-005-40491	<div>Feet</div> <div>0255075</div> <div>1 in = 50 feet</div> <div></div>
	DATE: 4/26/20	PROJECT NUMBER: 1974116		
	DRAWN BY: CN	PROJECT MANAGER: A. Chadd		