


1 LOCATION OF WATER WELL: Fraction 1/4 SE 1/4 SE 1/4 Section Number 18 Township Number T 17 S Range Number R 12 E
 County: Barton Distance and direction from nearest town or city street address of well if located within city?

2 WATER WELL OWNER: Marbet Prosser
 RR#, St. Address, Box #: RT. 1 Board of Agriculture, Division of Water Resources
 City, State, ZIP Code: Claffin Kan Application Number:

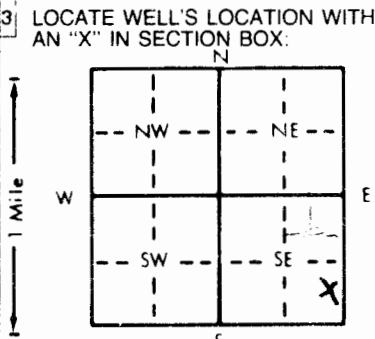

4 DEPTH OF COMPLETED WELL: 69 ft. ELEVATION:
 Depth(s) Groundwater Encountered 1. 24 ft. 2. 37 ft. 3. _____ ft.
 WELL'S STATIC WATER LEVEL: 24 ft. below land surface measured on mo/day/yr aug 15 - 95
 Pump test data: Well water was 22 ft. after 21 hours pumping _____ gpm
 Est. Yield 14 gpm; Well water was _____ ft. after _____ hours pumping _____ gpm
 Bore Hole Diameter: 8 1/2 in. to 69 ft. and _____ in. to _____ ft.
 WELL WATER TO BE USED AS:
 Domestic 3 Feedlot 6 Oil field water supply 9 Dewatering 12 Other (Specify below)
 2 Irrigation 4 Industrial 7 Lawn and garden only 10 Monitoring well
 Was a chemical/bacteriological sample submitted to Department? Yes _____ No X If yes, mo/day/yr sample was sub-
 mitted Water Well Disinfected? Yes X No

5 TYPE OF BLANK CASING USED:
 1 Steel 3 RMP (SR) 5 Wrought iron 8 Concrete tile CASING JOINTS Glued Clamped _____
 2 PVC 4 ABS 6 Asbestos-Cement 9 Other (specify below) Welded _____
 7 Fiberglass Threaded _____
 Blank casing diameter 5 in. to 69 ft. Dia _____ in. to _____ ft. Dia _____ in. to _____ ft.
 Casing height above land surface: 12 feet in. weight _____ lbs./ft. Wall thickness or gauge No. SDR-26
 TYPE OF SCREEN OR PERFORATION MATERIAL:
 1 Steel 3 Stainless steel 5 Fiberglass 8 RMP (SR) 11 Other (specify) _____
 2 Brass 4 Galvanized steel 6 Concrete tile 9 ABS 12 None used (open hole)
 SCREEN OR PERFORATION OPENINGS ARE:
 1 Continuous slot 3 Mill slot 5 Gauzed wrapped 8 Saw cut 11 None (open hole)
 2 Louvered shutter 4 Key punched 6 Wire wrapped 9 Drilled holes
 7 Torch cut 10 Other (specify) _____
 SCREEN-PERFORATED INTERVALS: From 45 ft. to 69 ft. From _____ ft. to _____ ft.
 From _____ ft. to _____ ft. From _____ ft. to _____ ft.
 GRAVEL PACK INTERVALS: From 45 ft. to 69 ft. From _____ ft. to _____ ft.
 From _____ ft. to _____ ft. From _____ ft. to _____ ft.

6 GROUT MATERIAL: Neat cement 2 Cement grout 3 Bentonite 4 Other _____
 Grout intervals: From 0 ft. to 20 ft. From _____ ft. to _____ ft. From _____ ft. to _____ ft.
 What is the nearest source of possible contamination:
 1 Septic tank 4 Lateral lines 7 Pit privy 10 Livestock pens 14 Abandoned water well
 2 Sewer lines 5 Cess pool 8 Sewage lagoon 11 Fuel storage 15 Oil well/Gas well
 3 Watertight sewer lines 6 Seepage pit 9 Feedyard 12 Fertilizer storage 16 Other (specify below)
 13 Insecticide storage
 Direction from well? Pond South of well How many feet? 450

FROM	TO	LITHOLOGIC LOG	FROM	TO	PLUGGING INTERVALS
0	3	top soil			
3	41	Brown clay Fin sand.			
41	64	sand			
64	69	Blue Clay Fin sand.			

7 CONTRACTOR'S OR LANDOWNER'S CERTIFICATION: This water well was constructed, reconstructed, or plugged under my jurisdiction and was completed on (mo/day/year) aug 17 - 95 and this record is true to the best of my knowledge and belief. Kansas Water Well Contractor's License No. 485 This Water Well Record was completed on (mo/day/yr) Sept 19 1995 under the business name of Bushnell water Drilling & Ser. by (signature) Frank Bushnell

OFFICE USE ONLY
T
R
E
W
SEC