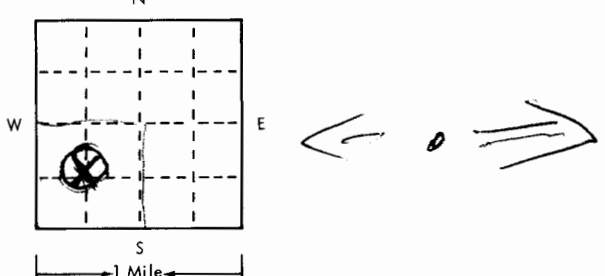


USE TYPEWRITER OR BALL POINT PEN-PRESS FIRMLY, PRINT CLEARLY.

T R EW sec 1/4 1/4 1/4 No.

WATER WELL RECORD
KSA 82a-1201-1215

Kansas State Dept. Of Health
(Water Well Contractors)
Forbes-Bldg. 740
Topeka, Kansas 66620

1 Location of well:	County BARTON	Township name Cheyenne	Fraction SW	Section number 13	Town number 17	Range number 12
2 Distance and direction from nearest town or city: Street address of well location if in city:			3 Owner of well: NORBERT PROSSER Address: Odin, KANS			
Locate with "X" in section below: N W E S 1 Mile			Sketch map: 		4 Well depth: 51 ft. Date of completion 2/4/77 Well diameter 7 in.	
2 Type and color of material			From To		5 <input checked="" type="checkbox"/> Cable tool <input type="checkbox"/> Rotary <input type="checkbox"/> Driven <input type="checkbox"/> Dug <input type="checkbox"/> Hollow rod <input type="checkbox"/> Jetted <input type="checkbox"/> Bored <input type="checkbox"/> Reverse rotary	
					6 Use: <input type="checkbox"/> Domestic <input type="checkbox"/> Public supply <input type="checkbox"/> Industry <input type="checkbox"/> Irrigation <input type="checkbox"/> Air conditioning <input type="checkbox"/> Commercial <input type="checkbox"/> Test well <input checked="" type="checkbox"/> Stock	
Top Soil Yellow/Brown Clay Red Rock Sand Rock			0 12 12 35 35 46 46 51		7 Casing: Material PVC Height: above/below Threaded <input type="checkbox"/> Welded <input type="checkbox"/> Surface 18 in. Diam. Weight _____ lbs./ft. _____ 5 in. to 51 ft. depth Drive shoe? <input type="checkbox"/> Yes <input type="checkbox"/> No _____ in. to _____ ft. depth	
					8 Screen: Modern pipe inc Manufacturer PVC Dia. 5" Type 1/16 Length 20 Slot/gauze 51 ft. and 31 ft. Set between _____ ft. and _____ ft. Fittings: Gravel pack <input checked="" type="checkbox"/> Yes <input type="checkbox"/> No Size range of material _____	
(use a second sheet if needed)					9 Static water level: 36 ft. below land surface Date 2-6-77	
					10 Pumping level below land surfaces: bailer test _____ ft. after _____ hrs. pumping _____ g.p.m. _____ ft. after _____ hrs. pumping _____ g.p.m. Estimated maximum yield 6 g.p.m.	
16 Remarks: elevation Topography: <input checked="" type="checkbox"/> Hill <input type="checkbox"/> Slope <input type="checkbox"/> Upland <input type="checkbox"/> Valley					11 Water sample submitted: <input type="checkbox"/> Yes <input checked="" type="checkbox"/> No Date _____	
					12 Well head completion: <input type="checkbox"/> Pitless adapter <input checked="" type="checkbox"/> _____ Inches above grade	
					13 Well grouted? <input checked="" type="checkbox"/> Yes <input type="checkbox"/> No <input checked="" type="checkbox"/> Neat cement <input type="checkbox"/> Bentonite <input type="checkbox"/> _____ Depth: From 14 ft. to 34 ft.	
					14 Nearest source of possible contamination: ft. 0 Direction _____ Type _____ Well disinfected upon completion? <input checked="" type="checkbox"/> Yes <input type="checkbox"/> No	
					15 Pump: <input type="checkbox"/> Not installed Manufacturer's name _____ Model number _____ HP _____ Volts _____ Length of drop pipe _____ ft. capacity _____ g.m.p. Type: <input type="checkbox"/> Submersible <input type="checkbox"/> Turbine WINDMILL <input type="checkbox"/> Jet <input type="checkbox"/> Reciprocating <input type="checkbox"/> Centrifugal <input type="checkbox"/> Other	
					17 Water well contractor's certification: This well was drilled under my jurisdiction and this report is true to the best of my knowledge and belief. SMALL'S WATER WELL DRILLING Business name _____ License No. 260 Address _____ Signed Edwin Small Date 1977 Authorized representative	

17 12 W 13 SW