

USE TYPEWRITER OR BALL POINT PEN-PRESS FIRMLY, PRINT CLEARLY.


WATER WELL RECORD
KSA 82a-1201-1215

T R EW sec 1/4 1/4 1/4 No.

Kansas State Dept. Of Health
(Water Well Contractors)
Forbes-Bldg. 740
Topeka, Kansas 66620

Location of well: County **Barton** Township name **Cheyenne** Fraction **NE 1/4** Section number **19** Town number **17** Range number **12**

Distance and direction from nearest town or city: **4 1/2 west of Odin, Kansas 67562** 3 Owner of well: **Joe Finger Hoisington, Kansas 67544**
Street address of well location if in city: Address:

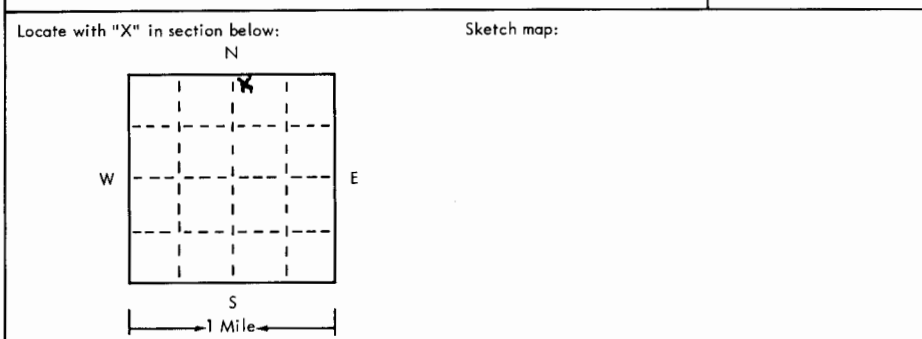

4 Well depth: **149** ft. Date of completion **5-20-78**
Well diameter **9** in.

5 Cable tool Rotary Driven Dug
 Hollow rod Jetted Bored Reverse rotary

6 Use: Domestic Public supply Industry
 Irrigation Air conditioning Commercial
 Test well **Stock**

7 Casing: Material **PVC** Height: above/below
Threaded Welded Surface **12**
Diam. **2.27** lbs./ft. **2.27**
5 in. to **149** ft. depth Drive shoe? Yes No

2	Type and color of material	From	To
	Surface	0	3
	Clay yellow	3	18
	Shale blue	18	72
	shell hard sandy (little water)	72	75
	Shale gray	75	103
	Sandy and hard	103	107
	Shale brown--gray	107	110
	Shale brown	110	120
	" " light	120	135
	135 sand rock (water)	135	143
	Shale Brown	143	149
	(use a second sheet if needed)		

8 Screen:
Manufacturer _____
Type _____ Dia. _____
Slot/gauze **drilled** Length **8'**
Set between **135** ft. and **143** ft.
Fittings:
Gravel pack Yes No Size range of material **1/2"**

9 Static water level:
45 ft. below land surface Date **5-20-78**

10 Pumping level below land surfaces:
_____ ft. after _____ hrs. pumping _____ g.p.m.
_____ ft. after _____ hrs. pumping _____ g.p.m.
Estimated maximum yield **12** g.p.m.

11 Water sample submitted:
 Yes No Date _____

12 Well head completion:
 Pitless adapter Inches above grade

13 Well grouted? Yes No
 Neat cement Bentonite _____
Depth: From **0** ft. to **30** ft.

14 Nearest source of possible contamination:
ft. _____ Direction _____ Type _____
Well disinfected upon completion? Yes No

15 Pump: Not installed
Manufacturer's name _____
Model number _____ HP _____ Volts _____
Length of drop pipe _____ ft. capacity _____ g.m.p.
Type:
 Submersible Turbine
 Jet Reciprocating
 Centrifugal Other **2" pump**

16 Remarks: elevation

Topography:
 Hill Slope **to the north**
 Upland Valley

17 Water well contractor's certification:
This well was drilled under my jurisdiction and this report is true to the best of my knowledge and belief.
Jezeq Water well drilling
Business **Holyrood, Kan.** License **191**
Address _____
Signed **Joe Finger** Date **5-2-78**
Authorized representative

17 12.00 19 NE corner