

USE TYPEWRITER OR BALL POINT PEN-PRESS FIRMLY, PRINT CLEARLY.


WATER WELL RECORD
KSA 82a-1201-1215

T R EW sec 1/4 1/4 1/4 No.

Kansas State Dept. Of Health
(Water Well Contractors)
Forbes-Bldg. 740
Topeka, Kansas 66620

Location of well: County **Barton** Township name **Cheyenne** Fraction **~~10~~ 70 1/4** Section number **~~24~~ 24** Town number **~~17~~ 17** Range number **~~12~~ 12**

Distance and direction from nearest town or city: **4 W + 3 N of Clifton, KS** 3 Owner of well: **Art Jincsh**
Street address of well location if in city: **Odin, Kansas 67562** Address:

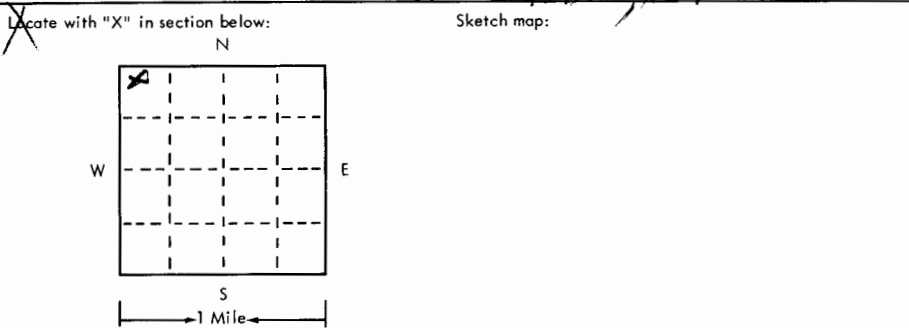

4 Well depth: **84** ft. Date of completion **5-24-77**
Well diameter **9** in.

5 Cable tool Rotary Driven Dug
 Hollow rod Jetted Bored Reverse rotary

6 Use: Domestic Public supply Industry
 Irrigation Air conditioning Commercial
 Test well

7 Casing: Material **PVC** Height above/below **MNC**
Threaded Welded Surface **18** in.
Diam. **5** in. Weight **2.277** lbs./ft.
5 in. to **84** ft. depth Drive shoe? Yes No

2	Type and color of material	From	To
	surface	0	4
	clay brown	55	65
	" " muddy gravel (water) 20 gal per min	55	65
	clay brown	65	79
	sand hard	79	82
	clay brown	82	84
	(use a second sheet if needed)		

8 Screen: **7/64" hole**
Manufacturer **plastic** Dia. **10** ft.
Slot/gauze **drilled** Length **10** ft.
Set between **55** ft. and **65** ft.
Fittings:
Gravel pack Yes No Size range of material **1/2**

9 Static water level: **40** ft. below land surface Date **5-24-77**

10 Pumping level below land surfaces:
___ ft. after ___ hrs. pumping ___ g.p.m.
___ ft. after ___ hrs. pumping ___ g.p.m.
Estimated maximum yield **20** g.p.m.

11 Water sample submitted:
 Yes No Date ___

12 Well head completion:
 Pitless adapter **18** inches above grade

13 Well grouted? Yes No
 Neat cement Bentonite ___
Depth: From **0** ft. to **40** ft.

14 Nearest source of possible contamination:
ft. **30** Direction **N** Type **Sewer**
Well disinfected upon completion? Yes No

15 Pump: Not installed
Manufacturer's name _____
Model number _____ HP _____ Volts _____
Length of drop pipe _____ ft. capacity _____ g.m.p.
Type:
 Submersible Turbine
 Jet Reciprocating
 Centrifugal Other

16 Remarks: elevation **1852**

Topography:
 Hill
 Slope
 Upland
 Valley

17 Water well contractor's certification:
This well was drilled under my jurisdiction and this report is true to the best of my knowledge and belief.
Jezeq Water Well Drilling
Business Name **Holyrod, Kan. 191** License No. _____
Address **Holyrod, Kan. 191**
Signed **Joe Jezeq** Date **5-24-77**
Authorized representative

17 12 W 24 SE 1/4