

USE TYPEWRITER OR BALL POINT PEN-PRESS FIRMLY, PRINT CLEARLY.

T R EW sec 1/4 1/4 1/4 No.


WATER WELL RECORD
KSA 82a-1201-1215

Kansas State Dept. Of Health
(Water Well Contractors)
Forbes-Bldg. 740
Topeka, Kansas 66620

SW SE SW

<input checked="" type="checkbox"/> Location of well:	County Barton	Township name Homestead	Fraction SW	Section number 23 34	Town number 16 17	Range number 11 12
---	-------------------------	-----------------------------------	-----------------------	---	--	---

Distance and direction from nearest town or city: 7 1/2 miles E of Hoisington	3 Owner of well: Martin Steiner Hoisington, Kansas 67544
---	--

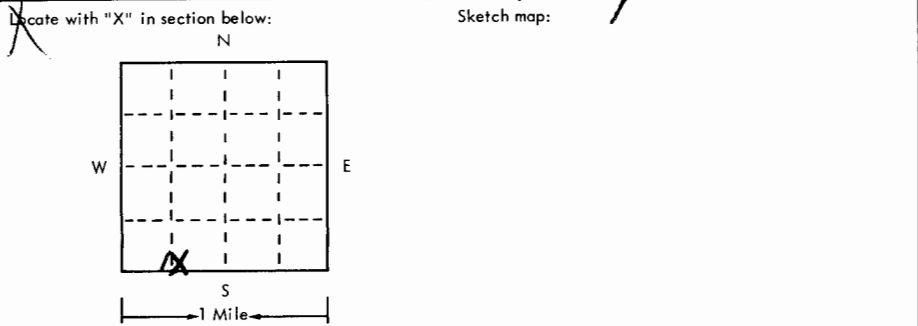

4 Well depth: 112 ft. Date of completion 5-25-77 Well diameter 5 1/2 in.
5 <input type="checkbox"/> Cable tool <input type="checkbox"/> Rotary <input type="checkbox"/> Driven <input type="checkbox"/> Dug <input type="checkbox"/> Hollow rod <input type="checkbox"/> Jetted <input type="checkbox"/> Bored <input type="checkbox"/> Reverse rotary
6 Use: <input type="checkbox"/> Domestic <input type="checkbox"/> Public supply <input type="checkbox"/> Industry <input type="checkbox"/> Irrigation <input type="checkbox"/> Air conditioning <input type="checkbox"/> Commercial <input type="checkbox"/> Test well <input checked="" type="checkbox"/> Stock well MNC
7 Casing: Material pvc Height: above/below Threaded <input type="checkbox"/> Welded <input checked="" type="checkbox"/> Surface 147 in Diam. _____ Weight 147 lbs./ft. 4 in. to 112 ft. depth Drive shoe? <input type="checkbox"/> Yes <input checked="" type="checkbox"/> No

2	Type and color of material	From	To
	Cleaned out and recased the well And bailed the well well is 60 years old. pumped with a windmill	92	112
	This well was cased with 4" casing run inside the old casing. There was no way to grout the well. MNC		
	(use a second sheet if needed)		

8 Screen: Manufacturer _____ Type drilled pvc Dia. 4" Slot/gauze Drilled Length 20 Set between 92 ft. and 112 ft. Fittings: Gravel pack <input type="checkbox"/> Yes <input checked="" type="checkbox"/> No Size range of material _____
9 Static water level: MNC 5/25/77 50 ft. below land surface Date
10 Pumping level below land surfaces: _____ ft. after _____ hrs. pumping _____ g.p.m. _____ ft. after _____ hrs. pumping _____ g.p.m. Estimated maximum yield _____ g.p.m.
11 Water sample submitted: <input type="checkbox"/> Yes <input checked="" type="checkbox"/> No Date _____
12 Well head completion: <input type="checkbox"/> Pitless adapter <input type="checkbox"/> Inches above grade
13 Well grouted? <input type="checkbox"/> Yes <input checked="" type="checkbox"/> No <input type="checkbox"/> Neat cement <input type="checkbox"/> Bentonite <input type="checkbox"/> _____ Depth: From _____ ft. to _____ ft.
14 Nearest source of possible contamination: ft. 200 Direction NE Type buried Well disinfected upon completion? <input type="checkbox"/> Yes <input checked="" type="checkbox"/> No
15 Pump: <input type="checkbox"/> Not installed Manufacturer's name _____ Model number _____ HP _____ Volts _____ Length of drop pipe _____ ft. capacity _____ g.m.p. Type: <input type="checkbox"/> Submersible <input type="checkbox"/> Turbine <input type="checkbox"/> Jet <input type="checkbox"/> Reciprocating <input type="checkbox"/> Centrifugal <input type="checkbox"/> Other

16 Remarks: elevation

Topography:
 Hill
 Slope
 Upland
 Valley **slope to SW**

1705

17 Water well contractor's certification:
This well was drilled under my jurisdiction and this report is true to the best of my knowledge and belief.
Jezeq Water Well Drilling
Business name _____ License No. **191**
Address _____
Signed **Joe Jezeq** Date **5-25-77**
Authorized representative

17 12 03 4 SW SE SW