

USE TYPEWRITER OR BALL POINT PEN-PRESS FIRMLY, PRINT CLEARLY.

T R EW sec 1/4 1/4 1/4 No.


WATER WELL RECORD
KSA 82a-1201-1215

Kansas State Dept. Of Health
(Water Well Contractors)
Forbes-Bldg. 740
Topeka, Kansas 66620

SE SW SE

Location of well:	County Barton	Township name Homestead	Fraction SW	Section number 35 35	Town number 17 17	Range number 12 12
-------------------	----------------------	--------------------------------	------------------------	--	-------------------------------------	--------------------------------------

Distance and direction from nearest town or city: 8 1/2 E of	3 Owner of well: Frank Wener
Street address of well location if in city: Hoisington, Ks.	Address: Hoisington Kansas 67544

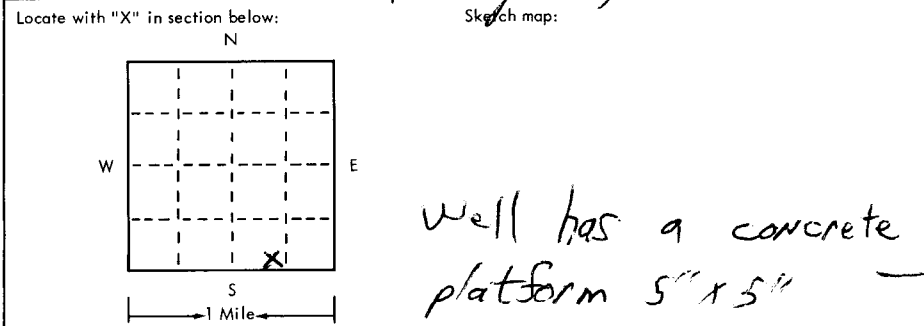

4 Well depth: 137 ft. Date of completion 5-26-77
Well diameter 5 1/2 in.

5 Cable tool Rotary Driven Dug
 Hollow rod Jetted Bored Reverse rotary

6 Use: Domestic Public supply Industry
 Irrigation Air conditioning Commercial
 Test well stock well

7 Casing: Material pvc Height: above/below
Threaded Welded Surf 7 1/2 in.
Diam. 4 in. to 1 40 depth Drive shoe? Yes No
4 in. to ft. depth

2	Type and color of material	From	To
	cleaned out & recased the well	128	137
	bailed the well		
	well is 60 years old		
	pumped with a wind mill		
	No way to grout.		
	4" casing set inside.		
	MHC		
	(use a second sheet if needed)		

8 Screen:
Manufacturer _____
Type drilled Dia. 4"
Slot/gauze _____ Length 20 ft
Set between 120 ft. and 140 ft.
Fittings:
Gravel pack Yes No Size range of material 4

9 Static water level:
107 ft. below land surface Date 5/26/77

10 Pumping level below land surfaces:
_____ ft. after _____ hrs. pumping _____ g.p.m.
_____ ft. after _____ hrs. pumping _____ g.p.m.
Estimated maximum yield _____ g.p.m.

11 Water sample submitted:
 Yes No Date _____

12 Well head completion:
 Pitless adapter Inches above grade

13 Well grouted? Yes No
 Neat cement Bentonite _____
Depth: From _____ ft. to _____ ft.

14 Nearest source of possible contamination:
ft. 300 Direction SW Type backyard
Well disinfected upon completion? Yes No

15 Pump: Not installed
Manufacturer's name _____
Model number _____ HP _____ Volts _____
Length of drop pipe _____ ft. capacity _____ g.m.p.
Type:
 Submersible Turbine
 Jet Reciprocating
 Centrifugal Other

16 Remarks: elevation 1881

Topography:
 Hill
 Slope
 Upland
 Valley

17 Water well contractor's certification:
This well was drilled under my jurisdiction and this report is true to the best of my knowledge and belief.
Jezek Water Well Drilling
Business name _____ Lic. No. _____
Address Holyrood
Signed _____ Date 5-26-77
Authorized representative

17 12-11 35 SE SW SE