


1 LOCATION OF WATER WELL: County: Barton	Fraction SE 1/4 SW 1/4 SW 1/4	Section Number 8	Township Number T 17 S	Range Number R 12 E/W
---	----------------------------------	---------------------	---------------------------	--------------------------

Distance and direction from nearest town or city street address of well if located within city?
 Approximately 4 miles north and 1/2 mile west of Redwing

2 WATER WELL OWNER: Leon Klug
 RR#, St. Address, Box #: 228 Main
 City, State, ZIP Code: Hoisington, KS 67544
 Board of Agriculture, Division of Water Resources
 Application Number:

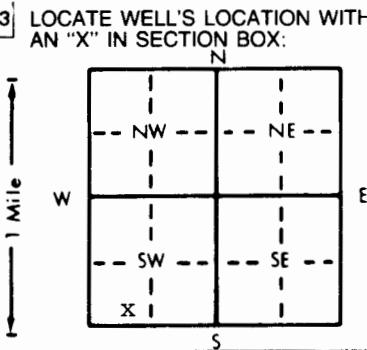

4 DEPTH OF COMPLETED WELL: 155 ft. ELEVATION: Unknown

Depth(s) Groundwater Encountered 1. ft. 2. ft. 3. ft.

WELL'S STATIC WATER LEVEL: 128.55 ft. below land surface measured on mo/day/yr 5-16-96

Pump test data: Well water was not ch'd ft. after hours pumping gpm

Est. Yield unknown gpm: Well water was ft. after hours pumping gpm

Bore Hole Diameter: 8 3/4 in. to 156 ft. and in. to ft.

WELL WATER TO BE USED AS:

5 Public water supply	8 Air conditioning	11 Injection well
1 Domestic	3 Feedlot	6 Oil field water supply
2 Irrigation	4 Industrial	7 Lawn and garden only
		10 Monitoring well

12 Other (Specify below)
Stock Well

Was a chemical/bacteriological sample submitted to Department? Yes No If yes, mo/day/yr sample was submitted

Water Well Disinfected? Yes No

5 TYPE OF BLANK CASING USED:

1 Steel	3 RMP (SR)	5 Wrought iron	8 Concrete tile	CASING JOINTS: Glued <input checked="" type="checkbox"/> Clamped
2 PVC	4 ABS	6 Asbestos-Cement	9 Other (specify below)	Welded
		7 Fiberglass		Threaded

Blank casing diameter 5 in. to 101 ft. Dia 5 in. to 123 ft. Dia 5 in. to 137 ft.

Casing height above land surface 12 in., weight 2.36 lbs./ft. Wall thickness or gauge No. .214

TYPE OF SCREEN OR PERFORATION MATERIAL:

1 Steel	3 Stainless steel	5 Fiberglass	8 RMP (SR)	10 Asbestos-cement
2 Brass	4 Galvanized steel	6 Concrete tile	9 ABS	11 Other (specify)
				12 None used (open hole)

SCREEN OR PERFORATION OPENINGS ARE:

1 Continuous slot	3 Mill slot	5 Gauzed wrapped	8 Saw cut	11 None (open hole)
2 Louvered shutter	4 Key punched	6 Wire wrapped	9 Drilled holes	
		7 Torch cut	10 Other (specify)	

SCREEN-PERFORATED INTERVALS: From 101 ft. to 118 ft., From 137 ft. to 154 ft.

From 123 ft. to 131 ft., From ft. to ft.

GRAVEL PACK INTERVALS: From 95 ft. to 117 ft., From 136 ft. to 156 ft.

From 122 ft. to 130 ft., From ft. to ft.

6 GROUT MATERIAL: Chlorinated Sand, 1 Neat cement, 2 Cement grout, 3 Bentonite, 4 Other Bentonite Holeplug

Grout Intervals: From 20 ft. to 90 ft., From 0-20 ft. to 90-95 ft., From 117-122 ft. to 130-136 ft.

What is the nearest source of possible contamination:

1 Septic tank	4 Lateral lines	7 Pit privy	10 Livestock pens	14 Abandoned water well
2 Sewer lines	5 Cess pool	8 Sewage lagoon	11 Fuel storage	15 Oil well/Gas well
3 Watertight sewer lines	6 Seepage pit	9 Feedyard	12 Fertilizer storage	16 Other (specify below)
			13 Insecticide storage	None known

Direction from well? How many feet?

FROM	TO	LITHOLOGIC LOG	FROM	TO	PLUGGING INTERVALS
0	2	Topsoil	153	154	Rock, brown, hard
2	8	Clay, gray, hard	154	156	Sandstone, gray, fine to very fine
8	26	Clay, tan and white, hard			
26	32	Clay, tan, hard			
32	34	Clay, gray, hard			
34	51	Shale, black, flaky, hard			
51	53	Rock, white, hard			
53	95	Clay, black, flaky, hard			
95	117	Sandstone, gray, fine to very fine, hard			
117	122	Clay, white, hard			
122	130	Sandstone, gray, fine to very fine, hard			
130	136	Clay, reddish gray, hard			
136	153	Sandstone, gray, fine to very fine			

7 CONTRACTOR'S OR LANDOWNER'S CERTIFICATION: This water well was (1) constructed, (2) reconstructed, or (3) plugged under my jurisdiction and was completed on (mo/day/year) 5-16-96 and this record is true to the best of my knowledge and belief. Kansas Water Well Contractor's License No. 185 This Water Well Record was completed on (mo/day/yr) 5-21-96 under the business name of Clarke Well & Equipment, Inc. by (signature) *Clarke Well & Equipment*

OFFICE USE ONLY
T
R
EW
SEC.