


1 LOCATION OF WATER WELL: County: **BARTON** Fraction: **SE 1/4 NW 1/4 NW 1/4** Section Number: **36** Township Number: **T 17 S** Range Number: **R 12 E 10**

Distance and direction from nearest town or city street address of well if located within city?
2 1/8 m South of Odin KS East into

2 WATER WELL OWNER: **Mike Hekele**
 RR#, St. Address, Box #: **1184 NE 90th Ave**
 City, State, ZIP Code: **Clifton KS 67525**
 Board of Agriculture, Division of Water Resources
 Application Number:

3 LOCATE WELL'S LOCATION WITH AN "X" IN SECTION BOX:

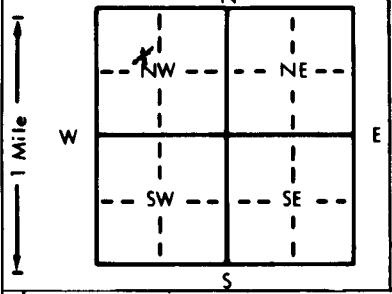

4 DEPTH OF COMPLETED WELL: **178** ft. ELEVATION: ft.
 Depth(s) Groundwater Encountered 1. **165** ft. 2. ft. 3. ft.
 WELL'S STATIC WATER LEVEL: **105** ft. below land surface measured on mo/day/yr **7-29-02**
 Pump test data: Well water was ft. after hours pumping gpm
 Est. Yield gpm Well water was ft. after hours pumping gpm
 Bore Hole Diameter: **8 3/4** in. to **178** ft., and in. to ft.
 WELL WATER TO BE USED AS:
 Domestic 3 Feedlot 6 Oil field water supply 9 Dewatering 12 Other (Specify below)
 2 Irrigation 4 Industrial 7 Lawn and garden only 10 Monitoring well
 Was a chemical/bacteriological sample submitted to Department? Yes No ; If yes, mo/day/yr sample was submitted
 Water Well Disinfected? Yes No

5 TYPE OF BLANK CASING USED:
 1 Steel 3 RMP (SR) 5 Wrought iron 8 Concrete tile CASING JOINTS: Glued Clamped
 PVC 4 ABS 7 Fiberglass Welded
 Blank casing diameter **5** in. to **160** ft., Dia in. to ft., Dia in. to ft.
 Casing height above land surface **18** in., weight **Sed 80** lbs./ft. Wall thickness or gauge No. **SDR 21**
 TYPE OF SCREEN OR PERFORATION MATERIAL:
 1 Steel 3 Stainless steel 5 Fiberglass 8 RMP (SR) 10 Asbestos-cement
 2 Brass 4 Galvanized steel 6 Concrete tile 9 ABS 12 None used (open hole)
 SCREEN OR PERFORATION OPENINGS ARE:
 1 Continuous slot Mill slot 5 Gauzed wrapped 8 Saw cut 11 None (open hole)
 2 Louvered shutter 4 Key punched 6 Wire wrapped 9 Drilled holes
 7 Torch cut 10 Other (specify)
 SCREEN-PERFORATED INTERVALS: From **178** ft. to **160** ft. From ft. to ft.
 From ft. to ft. From ft. to ft.
 GRAVEL PACK INTERVALS: From **178** ft. to **150** ft. From ft. to ft.
 From ft. to ft. From ft. to ft.

6 GROUT MATERIAL: 1 Neat cement 2 Cement grout Bentonite 4 Other
 Grout Intervals: From **150** ft. to **-3'** ft. From ft. to ft. From ft. to ft.
 What is the nearest source of possible contamination:
 1 Septic tank 4 Lateral lines 7 Pit privy 11 Fuel storage 14 Abandoned water well
 2 Sewer lines 5 Cess pool 8 Sewage lagoon 12 Fertilizer storage 15 Oil well/Gas well
 3 Watertight sewer lines 6 Seepage pit 9 Feedyard 13 Insecticide storage 16 Other (specify below)
 Direction from well? How many feet?

FROM	TO	LITHOLOGIC LOG	FROM	TO	PLUGGING INTERVALS
0	2	Soil			
2	45	Yellow clay			
45	75	Blue shale			
75	80	lime stone			
80	130	Blue shale			
120	160	Blue & white shale			
160	165	White sandy shale			
165	170	Sand white med			
170	178	Red shale			

7 CONTRACTOR'S OR LANDOWNER'S CERTIFICATION: This water well was constructed, (2) reconstructed, or (3) plugged under my jurisdiction and was completed on (mo/day/year) **7-29-02** and this record is true to the best of my knowledge and belief. Kansas Water Well Contractor's License No. **660** This Water Well Record was completed on (mo/day/yr) **7-29-02** under the business name of **Goodman Water Well Dry.** by (signature) **John Good**