


1 LOCATION OF WATER WELL: County: Barton	Fraction SE 1/4 SW 1/4 SE 1/4	Section Number 34	Township Number T 17 S	Range Number R 13 EW
---	----------------------------------	----------------------	---------------------------	------------------------------------

Distance and direction from nearest town or city street address of well if located within city?
 Approx. 1 miles east of Hoisington, KS

2 WATER WELL OWNER: Dee Dove
 RR#, St. Address, Box # : 4217 West 10th
 City, State, ZIP Code : Great Bend, KS 67530
 Board of Agriculture, Division of Water Resources
 Application Number: not required

3 LOCATE WELL'S LOCATION WITH AN "X" IN SECTION BOX:

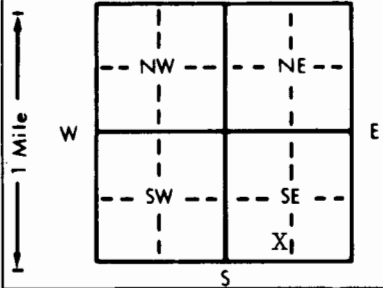

4 DEPTH OF COMPLETED WELL... 58 ft. ELEVATION: unknown
 Depth(s) Groundwater Encountered 1. 23 ft. 2. ft. 3. ft.
 WELL'S STATIC WATER LEVEL... 23 ft. below land surface measured on mo/day/yr... 9-30-81
 Pump test data: Well water was not ck'd ft. after... hours pumping... gpm
 Est. Yield unknown gpm: Well water was... ft. after... hours pumping... gpm
 Bore Hole Diameter... 9 in. to 58 ft., and... in. to... ft.
 WELL WATER TO BE USED AS:
 5 Public water supply 8 Air conditioning 11 Injection well
 1 Domestic 3 Feedlot 6 Oil field water supply 9 Dewatering 12 Other (Specify below)
 2 Irrigation 4 Industrial 7 Lawn and garden only 10 Observation well
 Was a chemical/bacteriological sample submitted to Department? Yes... No... X... If yes, mo/day/yr sample was submitted
 Water Well Disinfected? Yes XX No

5 TYPE OF BLANK CASING USED:
 1 Steel 3 RMP (SR) 5 Wrought iron 8 Concrete tile CASING JOINTS: Glued XX Clamped
 2 PVC 4 ABS 6 Asbestos-Cement 9 Other (specify below) Welded
 7 Fiberglass Threaded
 Blank casing diameter... 5 in. to 38 ft., Dia... 5 in. to 58 ft., Dia... in. to... ft.
 Casing height above land surface... 12 in., weight... 1.5 lbs./ft. Wall thickness or gauge No... 200
 TYPE OF SCREEN OR PERFORATION MATERIAL:
 1 Steel 3 Stainless steel 5 Fiberglass 8 RMP (SR) 10 Asbestos-cement 11 Other (specify)
 2 Brass 4 Galvanized steel 6 Concrete tile 9 ABS 12 None used (open hole)
 SCREEN OR PERFORATION OPENINGS ARE:
 1 Continuous slot 3 Mill slot 5 Gauzed wrapped 8 Saw cut 11 None (open hole)
 2 Louvered shutter 4 Key punched 6 Wire wrapped 9 Drilled holes
 7 Torch cut 10 Other (specify)
 SCREEN-PERFORATED INTERVALS: From... 38 ft. to... 54 ft., From... ft. to... ft.
 GRAVEL PACK INTERVALS: From... 27 ft. to... 58 ft., From... ft. to... ft.
 annular fill From 10 ft. to 23 ft., From... ft. to... ft.

6 GROUT MATERIAL: 1 Neat cement 2 Cement grout 3 Bentonite 4 Other
 Grout Intervals: From... 0 ft. to... 10 ft., From... 23 ft. to... 27 ft., From... ft. to... ft.
 What is the nearest source of possible contamination:
 1 Septic tank 4 Lateral lines 7 Pit privy 11 Fuel storage 14 Abandoned water well
 2 Sewer lines 5 Cess pool 8 Sewage lagoon 12 Fertilizer storage 15 Oil well/Gas well
 3 Watertight sewer lines 6 Seepage pit 9 Feedyard 13 Insecticide storage . PASTURE LAND.
 Direction from well? all How many feet?

FROM	TO	LITHOLOGIC LOG	FROM	TO	LITHOLOGIC LOG
0	38	Topsoil & very soft brown & gray clay, a couple streaks of sand around 33'-34'			
38	44	Streaks of brown clay & streaks of sandstone			
44	54	XXXX Soft sandstone & a few streaks of clay			
54	58	Dakota clay			

7 CONTRACTOR'S OR LANDOWNER'S CERTIFICATION: This water well was (1) constructed, (2) reconstructed, or (3) plugged under my jurisdiction and was completed on (mo/day/year) 9-30-81 and this record is true to the best of my knowledge and belief. Kansas Water Well Contractor's License No. 185 This Water Well Record was completed on (mo/day/yr) 11-4-81 under the business name of Clarke Well & Eq., Inc. by (signature)

INSTRUCTIONS: Use typewriter or ball point pen, PLEASE PRESS FIRMLY and PRINT clearly. Please fill in blanks, underline or circle the correct answers. Send top three copies to Kansas Department of Health and Environment, Division of Environment, Environmental Geology Section, Topeka, KS 66620. Send one to WATER WELL OWNER and retain one for your records.