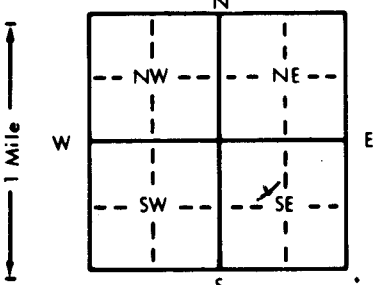


1 LOCATION OF WATER WELL: Fraction SE 1/4 NW 1/4 SE 1/4 Section Number 32 Township Number T 17 S Range Number R 13 E/W
 County: Barton
 Distance and direction from nearest town or city street address of well if located within city?

Hoisington ks 1507 N Clay
 2 WATER WELL OWNER: Owen Ochs
 RR#, St. Address, Box #: 1507 N: Clay Board of Agriculture, Division of Water Resources
 City, State, ZIP Code: Hoisington, ks. 67544 Application Number:

3 LOCATE WELL'S LOCATION WITH AN "X" IN SECTION BOX:

 4 DEPTH OF COMPLETED WELL: 45 ft. ELEVATION:
 Depth(s) Groundwater Encountered 1. 40 ft. 2. ft. 3. ft.
 WELL'S STATIC WATER LEVEL 18 ft. below land surface measured on mo/day/yr 8-25-02
 Pump test data: Well water was ft. after hours pumping gpm
 Est. Yield gpm: Well water was ft. after hours pumping gpm
 Bore Hole Diameter: 8 3/4 in. to ft., and in. to ft.
 WELL WATER TO BE USED AS: 5 Public water supply 8 Air conditioning 11 Injection well
 1 Domestic 3 Feedlot 6 Oil field water supply 9 Dewatering 12 Other (Specify below)
 2 Irrigation 4 Industrial Lawn and garden only 10 Monitoring well
 Was a chemical/bacteriological sample submitted to Department? Yes No ; If yes, mo/day/yr sample was sub-
 mitted Water Well Disinfected? Yes No

5 TYPE OF BLANK CASING USED: 5 Wrought iron 8 Concrete tile CASING JOINTS: Glued Clamped
 1 Steel 3 RMP (SR) 6 Asbestos-Cement 9 Other (specify below) Welded
 PVC 4 ABS 7 Fiberglass Threaded
 Blank casing diameter 5 in. to 35 ft., Dia in. to ft., Dia in. to ft.
 Casing height above land surface 16 in., weight Sec 40 lbs./ft. Wall thickness or gauge No. SD1.21
 TYPE OF SCREEN OR PERFORATION MATERIAL: PVC 10 Asbestos-cement
 1 Steel 3 Stainless steel 5 Fiberglass 8 RMP (SR) 11 Other (specify)
 2 Brass 4 Galvanized steel 6 Concrete tile 9 ABS 12 None used (open hole)
 SCREEN OR PERFORATION OPENINGS ARE: 5 Gauzed wrapped 8 Saw cut 11 None (open hole)
 1 Continuous slot Mill slot 6 Wire wrapped 9 Drilled holes
 2 Louvered shutter 4 Key punched 7 Torch cut 10 Other (specify)
 SCREEN-PERFORATED INTERVALS: From 35 ft. to 45 ft., From ft. to ft.
 From ft. to ft., From ft. to ft.
 GRAVEL PACK INTERVALS: From 35 ft. to 45 ft., From ft. to ft.
 From ft. to ft., From ft. to ft.

6 GROUT MATERIAL: 1 Neat cement 2 Cement grout Bentonite 4 Other
 Grout Intervals: From 0 ft. to 35 ft., From ft. to ft., From ft. to ft.
 What is the nearest source of possible contamination:
 1 Septic tank 4 Lateral lines 7 Pit privy 10 Livestock pens 14 Abandoned water well
 2 Sewer lines 5 Cess pool 8 Sewage lagoon 11 Fuel storage 15 Oil well/Gas well
 3 Watertight sewer lines 6 Seepage pit 9 Feedyard 12 Fertilizer storage 16 Other (specify below)
 13 Insecticide storage
 Direction from well? How many feet?

FROM	TO	LITHOLOGIC LOG	FROM	TO	PLUGGING INTERVALS
0	1	Soil			
1	38	Yellow & Gray Clay			
38	40	Red & White Clay			
40	43	White Sand Rock med			
43	45	Blue shale			

7 CONTRACTOR'S OR LANDOWNER'S CERTIFICATION: This water well was constructed, (2) reconstructed, or (3) plugged under my jurisdiction and was completed on (mo/day/year) 8-25-02 and this record is true to the best of my knowledge and belief. Kansas Water Well Contractor's License No. 660 This Water Well Record was completed on (mo/day/yr) 8-25-02 under the business name of Goodman water well Drly by (signature) Jak [Signature]

INSTRUCTIONS: Use typewriter or ball point pen. PLEASE PRESS FIRMLY and PRINT clearly. Please fill in blanks, underline or circle the correct answers. Send top three copies to Kansas Department of Health and Environment, Bureau of Water, Topeka, Kansas 66620-0001. Telephone: 913-296-5545. Send one to WATER WELL OWNER and retain one for your records.