


| | | | |
|------------------------------------|----------------|-----------------|--|
| 1 LOCATION OF WATER WELL: Fraction | Section Number | Township Number | Range Number |
| County: Barton NE ¼ SE ¼ NE ¼ | 34 | T 17 S | R 13 <input checked="" type="checkbox"/> W |

Distance and direction from nearest town or city street address of well if located within city?
 1½ East, 3/4 North of Hoisington

| | |
|---|---|
| 2 WATER WELL OWNER: Gene Manweiler | Board of Agriculture, Division of Water Resources |
| RR#, St. Address, Box # : 1151 NE 20th Ave | Application Number: WWO60409 |
| City, State, ZIP Code : Hoisington, Ks. 67544 | |

| | |
|--|---|
| 3 LOCATE WELL'S LOCATION WITH AN "X" IN SECTION BOX: | 4 DEPTH OF COMPLETED WELL 72 ft. ELEVATION: |
|--|---|

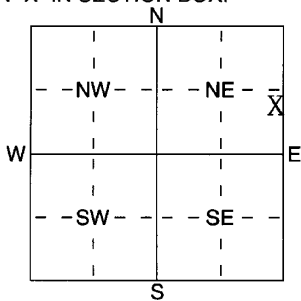

Depth(s) Groundwater Encountered 1 ft. 2 ft. 3 ft.
 WELL'S STATIC WATER LEVEL 33 ft. below land surface measured on mo/day/yr 4-13-06
 Pump test data: Well water was ft. after hours pumping gpm
 Est. Yield N/A gpm: Well water was ft. after hours pumping gpm
 WELL WATER TO BE USED AS:
 1 Domestic 2 Irrigation 3 Feedlot 4 Industrial 5 Public water supply 6 Oil field water supply 7 Domestic (lawn & garden)
 8 Air conditioning 9 Dewatering 10 Monitoring well 11 Injection well 12 Other (Specify below)

Was a chemical/bacteriological sample submitted to Department? Yes No X; If yes, mo/day/yrs sample was submitted
 Water Well Disinfected? Yes HTH No

| | | | |
|------------------------------|-------------------|-------------------------|---------------------------------------|
| 5 TYPE OF BLANK CASING USED: | 5 Wrought iron | 8 Concrete tile | CASING JOINTS: Glued <u>X</u> Clamped |
| 1 Steel | 6 Asbestos-Cement | 9 Other (specify below) | Welded |
| 2 <u>PVC</u> | 7 Fiberglass | | Threaded |
| 3 RMP (SR) | | | |
| 4 ABS | | | |

Blank casing diameter 5 in. to 32 ft., Dia in. to ft., Dia in. to ft.
 Casing height above land surface 36 in., weight SDR-26 lbs./ft. Wall thickness or gauge No.

| | | | | | |
|---|--------------------|-----------------|------------|--------------------|--------------------------|
| TYPE OF SCREEN OR PERFORATION MATERIAL: | | | | 7 PVC | 10 Asbestos-Cement |
| 1 Steel | 3 Stainless Steel | 5 Fiberglass | 8 RMP (SR) | 11 Other (Specify) | 12 None used (open hole) |
| 2 Brass | 4 Galvanized Steel | 6 Concrete tile | 9 ABS | | |

| | | | | | |
|-------------------------------------|---------------|----------------|--------------------|------------------|---------------------|
| SCREEN OR PERFORATION OPENINGS ARE: | | | 5 Guazed wrapped | 8 <u>Saw cut</u> | 11 None (open hole) |
| 1 Continuous slot | 3 Mill slot | 6 Wire wrapped | 9 Drilled holes | | |
| 2 Louvered shutter | 4 Key punched | 7 Torch cut | 10 Other (specify) | | |

SCREEN-PERFORATED INTERVALS: From 72 ft. to 32 ft., From ft. to ft.
 GRAVEL PACK INTERVALS: From 72 ft. to 20 ft., From ft. to ft.

| | | | | |
|-------------------|---------------|----------------|-------------|--------------------------------|
| 6 GROUT MATERIAL: | 1 Neat cement | 2 Cement grout | 3 Bentonite | 4 Other <u>hole plug</u> |
|-------------------|---------------|----------------|-------------|--------------------------------|

Grout Intervals: From ft. to ft., From ft. to ft., From 20 ft. to 0 ft.
 What is the nearest source of possible contamination:
 1 Septic tank 2 Sewer lines 3 Watertight sewer lines 4 Lateral lines 5 Cess pool 6 Seepage pit 7 Pit privy 8 Sewage lagoon 9 Feedyard 10 Livestock pens 11 Fuel storage 12 Fertilizer storage 13 Insecticide storage 14 Abandoned water well 15 Oil well/Gas well 16 Other (specify below) Garage
 Direction from well? Southwest How many feet? 50

| FROM | TO | LITHOLOGIC LOG | FROM | TO | PLUGGING INTERVALS |
|------|----|---------------------------|------|----|--------------------|
| 0 | 11 | Clay | | | |
| 11 | 46 | Sandrock & clay mixed | | | |
| 46 | 60 | Clay | | | |
| 60 | 72 | Yellow, gray, & fire clay | | | |
| | | | | | |
| | | | | | |
| |
|---|
| 7 CONTRACTOR'S OR LANDOWNER'S CERTIFICATION: This water well was (1) <u>constructed</u> , (2) reconstructed, or (3) plugged under my jurisdiction and was completed on (mo/day/year) 4-26-06 and this record is true to the best of my knowledge and belief. Kansas Water Well Contractor's Licence No 134 This Water Well Record was completed on (mo/day/yr) 4-28-06 under the business name of <u>Rosencrantz-Bemis</u> by (signature) <u>Gene Albert</u> |
|---|