

1 LOCATION OF WATER WELL: County: Barton Fraction: NE 1/4 NE 1/4 SE 1/4 Section Number: 9 Township Number: T 17 S Range Number: R 13 EW

Distance and direction from nearest town or city street address of well if located within city?

2 mi N of Susank

2 WATER WELL OWNER: National Cooperative Refinery Association


RR#, St. Address, Box # : P.O. Box 1404

Board of Agriculture, Division of Water Resources

City, State, ZIP Code : McPherson, Kansas 67460

Application Number:

3 LOCATE WELL'S LOCATION WITH AN "X" IN SECTION BOX:

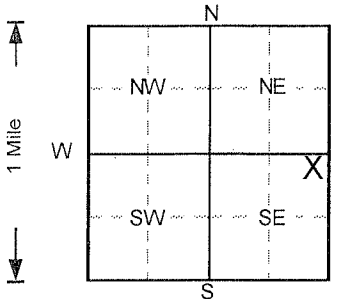

4 DEPTH OF COMPLETED WELL: 40 ft. ELEVATION: ... Depth(s) Groundwater Encountered ... WELL'S STATIC WATER LEVEL ... 32 ft. below land surface ... Recovery well ...

5 TYPE OF BLANK CASING USED: 2 PVC ... CASING JOINTS: Threaded ... TYPE OF SCREEN OR PERFORATION MATERIAL: 7 PVC ... SCREEN OR PERFORATION OPENINGS ARE: 3 Mill slot ... GRAVEL PACK INTERVALS: From 23 ft to 40 ft ...

6 GROUT MATERIAL: 3 Bentonite, 4 Other Concrete ... Grout Intervals: From 0 ft to 1 ft ... What is the nearest source of possible contamination: 11 Fuel storage ...

Table with 6 columns: FROM, TO, LITHOLOGIC LOG, FROM, TO, PLUGGING INTERVALS. Rows show lithology from 0-3 ft (Clay, silty, Dark Brown) to 32-40 ft (Shale, wthr..) and a plugged interval at RW23, Abovegrade.

7 CONTRACTOR'S OR LANDOWNER'S CERTIFICATION: This water well was (1) constructed ... 3/26/2013 ... Kansas Water Well Contractor's License No. 527 ... GeoCore, Inc. ... Date [Signature] 4/17/2013