


1 LOCATION OF WATER WELL: Fraction Section Number Township Number Range Number
 County: Barton NE 1/4 NE 1/4 NE 1/4 18 T 17 S R 13W E/W

Distance and direction from nearest town or city street address of well if located within city?
 4 N, 1 W of Hoisington, Kansas

2 WATER WELL OWNER: Alan Hoffman
 RR#. St. Address, Box #: Route 2, Box 81 Board of Agriculture, Division of Water Resources
 City, State, ZIP Code: Hoisington, Kansas 67544 Application Number:

3 LOCATE WELL'S LOCATION WITH AN "X" IN SECTION BOX: 4 DEPTH OF COMPLETED WELL: 223 ft. ELEVATION: Unknown

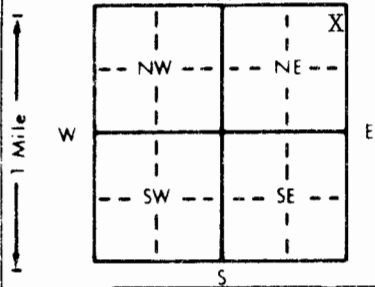

Depth(s) Groundwater Encountered 1. 175 ft. 2. ft. 3. ft.
 WELL'S STATIC WATER LEVEL 175 ft. below land surface measured on mo/day/yr 8/10/94
 Pump test data: Well water was ft. after hours pumping gpm
 Est. Yield 15 gpm Well water was ft. after hours pumping gpm
 Bore Hole Diameter 8 in. to 223 ft. and in. to ft.
 WELL WATER TO BE USED AS: 5 Public water supply 8 Air conditioning 11 Injection well
 1 Domestic 3 Feedlot 6 Oil field water supply 9 Dewatering 12 Other (Specify below)
 2 Irrigation 4 Industrial 7 Lawn and garden only 10 Monitoring well
 Was a chemical/bacteriological sample submitted to Department? Yes No If yes, mo/day/yr sample was submitted
 Water Well Disinfected? Yes No

5 TYPE OF BLANK CASING USED: 5 Wrought iron 8 Concrete tile CASING JOINTS: Glued Clamped
 1 Steel 3 RMP (SR) 6 Asbestos-Cement 9 Other (specify below) Welded
 2 PVC 4 ABS 7 Fiberglass Threaded
 Blank casing diameter 5 in. to 203 ft. Dia. in. to ft. Dia. in. to ft.
 Casing height above land surface 12 in. weight 2.8 lbs./ft. Wall thickness or gauge No. Sch. 40

TYPE OF SCREEN OR PERFORATION MATERIAL: 7 PVC 10 Asbestos-cement
 1 Steel 3 Stainless steel 5 Fiberglass 8 RMP (SR) 11 Other (specify)
 2 Brass 4 Galvanized steel 6 Concrete tile 9 ABS 12 None used (open hole)

SCREEN OR PERFORATION OPENINGS ARE: 5 Gauzed wrapped 8 Saw cut 11 None (open hole)
 1 Continuous slot 3 Mill slot 6 Wire wrapped 9 Drilled holes
 2 Louvered shutter 4 Key punched 7 Torch cut 10 Other (specify)

SCREEN-PERFORATED INTERVALS: From 203 ft. to 223 ft. From ft. to ft.
 GRAVEL PACK INTERVALS: From 20 ft. to 223 ft. From ft. to ft.

6 GROUT MATERIAL: 1 Neat cement 2 Cement grout 3 Bentonite 4 Other
 Grout intervals: From 0 ft. to 20 ft. From ft. to ft. From ft. to ft.

What is the nearest source of possible contamination:
 1 Septic tank 4 Lateral lines 7 Pit privy 10 Livestock pens 14 Abandoned water well
 2 Sewer lines 5 Cess pool 8 Sewage lagoon 11 Fuel storage 15 Oil well/Gas well
 3 Watertight sewer lines 6 Seepage pit 9 Feedyard 12 Fertilizer storage 16 Other (specify below)
 Direction from well? West How many feet? 300

| FROM | TO | LITHOLOGIC LOG | FROM | TO | PLUGGING INTERVALS |
|------|-----|----------------|------|----|--------------------|
| 0 | 3 | Top soil | | | |
| 3 | 35 | Lime stone | | | |
| 35 | 200 | Shale | | | |
| 200 | 223 | Sand rock | | | |

7 CONTRACTOR'S OR LANDOWNER'S CERTIFICATION: This water well was (1) constructed, (2) reconstructed, or (3) plugged under my jurisdiction and was completed on (mo/day/year) 8/10/94 and this record is true to the best of my knowledge and belief. Kansas
 Water Well Contractor's License No. 186 This Water Well Record was completed on (mo/day/yr) 8/12/94
 under the business name of Kelly's Water Well Service, Inc. by (signature) *Alous Good*

OFFICE USE ONLY
T
R
E/W
SEC.
1/4
1/4
1/4