


1 LOCATION OF WATER WELL:	Fraction NE 1/4 NE 1/4 NE 1/4	Section Number 26	Township Number T 17 S	Range Number R 15 EW
---------------------------	-------------------------------	-------------------	------------------------	-----------------------------

Distance and direction from nearest town or city street address of well if located within city?
 1/4 mile west, 2 miles north of Olmitz, Kansas

2 WATER WELL OWNER: Rose Cantrell
 RR#, St. Address, Box # : 8256 Mimico South
 City, State, ZIP Code : Millersville, M.D. 21108
 Board of Agriculture, Division of Water Resources
 Application Number:

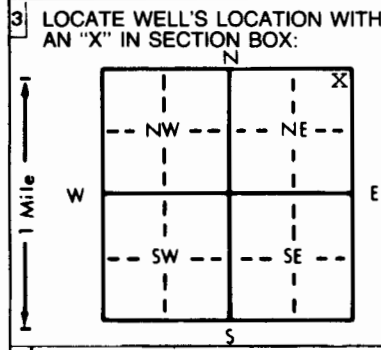

4 DEPTH OF COMPLETED WELL: 275 ft. ELEVATION: Valley

Depth(s) Groundwater Encountered 1. 245 ft. 2. ft. 3. ft.

WELL'S STATIC WATER LEVEL: 95 ft. below land surface measured on mo/day/yr 8/30/96

Pump test data: Well water was 95 ft. after 1 hours pumping 20 gpm
 Est. Yield 20 gpm: Well water was ft. after hours pumping gpm

Bore Hole Diameter: 10 in. to 275 ft., and in. to ft.

WELL WATER TO BE USED AS:

1 Domestic	3 Feedlot	6 Oil field water supply	9 Dewatering	12 Other (Specify below)
2 Irrigation	4 Industrial	7 Lawn and garden only	10 Monitoring well	

Was a chemical/bacteriological sample submitted to Department? Yes No ; If yes, mo/day/yr sample was submitted

Water Well Disinfected? Yes No

5 TYPE OF BLANK CASING USED: 2 5 Wrought iron 8 Concrete tile CASING JOINTS: Glued Clamped
 1 Steel 3 RMP (SR) 6 Asbestos-Cement 9 Other (specify below) Welded
 2 PVC 4 ABS 7 Fiberglass Threaded

Blank casing diameter . in. to 255 in. Dia . in. to . ft., Dia . in. to . ft.
 Casing height above land surface 24 in. weight 2.29 lbs./ft. Wall thickness or gauge No. .26

TYPE OF SCREEN OR PERFORATION MATERIAL:

1 Steel	3 Stainless steel	5 Fiberglass	8 RMP (SR)	10 Asbestos-cement
2 Brass	4 Galvanized steel	6 Concrete tile	9 ABS	11 Other (specify)
12 None used (open hole)				

SCREEN OR PERFORATION OPENINGS ARE: 8 5 Gauzed wrapped 8 Saw cut 11 None (open hole)
 1 Continuous slot 3 Mill slot 6 Wire wrapped 9 Drilled holes
 2 Louvered shutter 4 Key punched 7 Torch cut 10 Other (specify)

SCREEN-PERFORATED INTERVALS: From 275 ft. to 255 ft., From ft. to ft.
 From ft. to ft., From ft. to ft.

GRAVEL PACK INTERVALS: From 275 ft. to 30 ft., From ft. to ft.
 From ft. to ft., From ft. to ft.

6 GROUT MATERIAL: 3 1 Neat cement 2 Cement grout 3 Bentonite 4 Other

Grout Intervals: From 0 ft. to 30 ft., From ft. to ft., From ft. to ft.

What is the nearest source of possible contamination: None

1 Septic tank	4 Lateral lines	7 Pit privy	10 Livestock pens	14 Abandoned water well
2 Sewer lines	5 Cess pool	8 Sewage lagoon	11 Fuel storage	15 Oil well/Gas well
3 Watertight sewer lines	6 Seepage pit	9 Feedyard	12 Fertilizer storage	16 Other (specify below)
			13 Insecticide storage	

Direction from well? How many feet?

FROM	TO	LITHOLOGIC LOG	FROM	TO	PLUGGING INTERVALS
0	3	Topsoil			
3	8	Gumbo			
8	15	Sand			
15	17	Rock			
17	75	Shale			
75	93	Dakota clay			
93	105	Sandrock			
105	113	Dakota clay			
113	130	Sandy clay			
130	156	Red clay			
156	160	Clay, coarse rock			
160	195	Red clay			
195	210	Clay, sandrock layers			
210	245	Red clay			
245	275	Sandrock			

7 CONTRACTOR'S OR LANDOWNER'S CERTIFICATION: This water well was (1) constructed, (2) reconstructed, or (3) plugged under my jurisdiction and was completed on (mo/day/year) 8/30/96 and this record is true to the best of my knowledge and belief. Kansas Water Well Contractor's License No. 199 This Water Well Record was completed on (mo/day/yr) 9/19/96 under the business name of Karst Water Well Drilling & Service, Inc. by signature *[Signature]*

OFFICE USE ONLY
T
R
EW
SEC
1/4
1/4