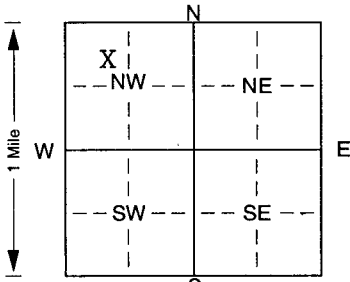


1 LOCATION OF WATER WELL: Fraction Section Number Township Number Range Number  
 County: Barton SE ¼ NW ¼ NW ¼ 25 T 17 S R 15 ~~E/W~~

Distance and direction from nearest town or city street address of well if located within city?  
2 miles north of Olmitz KS, east side

2 WATER WELL OWNER: Lester Lindsay  
 RR#, St. Address, Box # : 223 Washington Ave Board of Agriculture, Division of Water Resources  
 City, State, ZIP Code : Olmitz KS 67564 Application Number:

3 LOCATE WELL'S LOCATION WITH AN "X" IN SECTION BOX:  4 DEPTH OF COMPLETED WELL: 280 ft. ELEVATION: upland  
 Depth(s) Groundwater Encountered 1. .... ft. 2. .... ft. 3. .... ft.  
 WELL'S STATIC WATER LEVEL 100 ft. below land surface measured on mo/day/yr 1/3/02  
 Pump test data: Well water was 100 ft. after 2 hours pumping 20 gpm  
 Est. Yield 20 gpm: Well water was .... ft. after .... hours pumping .... gpm  
 Bore Hole Diameter: 10 in. to 280 ft., and .... in. to .... ft.  
 WELL WATER TO BE USED AS: 1 5 Public water supply 8 Air conditioning 11 Injection well  
1 Domestic 3 Feedlot 6 Oil field water supply 9 Dewatering 12 Other (Specify below)  
 2 Irrigation 4 Industrial 7 Domestic (lawn & garden) 10 Monitoring well  
 Was a chemical/bacteriological sample submitted to Department? Yes. .... No. X; If yes, mo/day/yr sample was submitted  
 Water Well Disinfected? Yes X No

5 TYPE OF BLANK CASING USED: 2 5 Wrought iron 8 Concrete tile CASING JOINTS: Glued. X Clamped. ....  
 1 Steel 3 RMP (SR) 6 Asbestos-Cement 9 Other (specify below) Welded .....  
2 PVC 4 ABS 7 Fiberglass ..... Threaded .....  
 Blank casing diameter 5 in. to 260 ft., Dia ..... in. to ..... ft., Dia ..... in. to ..... ft.  
 Casing height above land surface 24 in., weight 2.29 lbs./ft. Wall thickness or gauge No. 26  
 TYPE OF SCREEN OR PERFORATION MATERIAL: 7 7 PVC 10 Asbestos-cement  
 1 Steel 3 Stainless steel 5 Fiberglass 8 RMP (SR) 11 Other (specify) .....  
 2 Brass 4 Galvanized steel 6 Concrete tile 9 ABS 12 None used (open hole)  
 SCREEN OR PERFORATION OPENINGS ARE: 8 5 Gauzed wrapped 8 Saw cut 11 None (open hole)  
 1 Continuous slot 3 Mill slot 6 Wire wrapped 9 Drilled holes  
 2 Louvered shutter 4 Key punched 7 Torch cut 10 Other (specify) ..... ft.  
 SCREEN-PERFORATED INTERVALS: From 280 ft. to 260 ft., From ..... ft. to ..... ft.  
 From ..... ft. to ..... ft., From ..... ft. to ..... ft.  
 GRAVEL PACK INTERVALS: From 35 ft. to 280 ft., From ..... ft. to ..... ft.  
 From ..... ft. to ..... ft., From ..... ft. to ..... ft.

6 GROUT MATERIAL: 3 1 Neat cement 2 Cement grout 3 Bentonite 4 Other .....  
 Grout Intervals: From 0 ft. to 35 ft., From ..... ft. to ..... ft., From ..... ft. to ..... ft.  
 What is the nearest source of possible contamination:  
 1 Septic tank 4 Lateral lines 7 Pit privy 10 Livestock pens 14 Abandoned water well  
 2 Sewer lines 5 Cess pool 8 Sewage lagoon 11 Fuel storage 15 Oil well/Gas well  
 3 Watertight sewer lines 6 Seepage pit 9 Feedyard 12 Fertilizer storage 16 Other (specify below)  
 13 Insecticide storage .....  
 Direction from well? How many feet?

FROM	TO	LITHOLOGIC LOG	FROM	TO	PLUGGING INTERVALS
0	4	Topsoil			
4	15	Gumbo/some sand			
15	20	Clay and rock layers			
20	75	Shale			
75	110	Dakota clay			
110	140	White clay			
140	150	Red clay			
150	155	Clay/some sand/rock			
155	195	Red clay			
195	220	Grey clay			
220	240	Red clay			
240	255	Grey clay			
255	280	Sand/rock			

7 CONTRACTOR'S OR LANDOWNER'S CERTIFICATION: This water well was (1) constructed, (2) reconstructed, or (3) plugged under my jurisdiction and was completed on (mo/day/year) 1/3/02 and this record is true to the best of my knowledge and belief. Kansas Water Well Contractor's Licence No. 199. This Water Well Record was completed on (mo/day/yr) 1/22/02 under the business name of Karst Water Well Drilling & Service, Inc. by (signature) Mel Karst