


1 LOCATION OF WATER WELL: County: Rush Fraction: NW 1/4 NW 1/4 NW 1/4 Section Number: 36 Township Number: T 17 S Range Number: R 16 EW

Distance and direction from nearest town or city street address of well if located within city? 231 N. Main, Otis

2 WATER WELL OWNER: OK Oil Service RR#, St. Address, Box #: PO Box 349 City, State, ZIP Code: Otis, Kansas 67565 Board of Agriculture, Division of Water Resources Application Number:

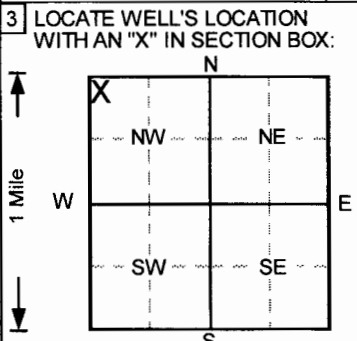

3 LOCATE WELL'S LOCATION WITH AN "X" IN SECTION BOX: 4 DEPTH OF COMPLETED WELL: 30 ft. ELEVATION: 2035.97. WELL'S STATIC WATER LEVEL: 18.75 ft. below land surface measured on mo/day/yr 5/10/2007. Pump test data: Well water was NA ft. after ... hours pumping ... gpm. Est. Yield: NA gpm. Well water was ... ft. after ... hours pumping ... gpm. Bore Hole Diameter: 8 in. to 30 ft., and ... in. to ... ft. WELL WATER TO BE USED AS: 5 Public water supply, 8 Air conditioning, 11 Injection well, 1 Domestic, 3 Feedlot, 6 Oil field water supply, 9 Dewatering, 12 Other (Specify below), 2 Irrigation, 4 Industrial, 7 Lawn and garden only, 10 Monitoring well. Was a chemical/bacteriological sample submitted to Department? Yes.....No [checked] ; If yes, mo/day/yr sample was submitted. Water Well Disinfected? Yes No [checked]

5 TYPE OF BLANK CASING USED: 1 Steel, 2 PVC, 3 RMP (SR), 4 ABS, 5 Wrought iron, 6 Asbestos-Cement, 7 Fiberglass, 8 Concrete tile, 9 Other (specify below), 10 Asbestos-cement, 11 Other (specify), 12 None used (open hole). CASING JOINTS: Glued, Clamped, Welded, Threaded [checked]. Blank casing diameter: 2 in. to 15 ft. Dia. in. to ... ft. Dia. in. to ... ft. Casing height above land surface: -6.72 in., weight ... lbs./ft. Wall thickness or gauge No. Sch. 40. TYPE OF SCREEN OR PERFORATION MATERIAL: 1 Steel, 2 Brass, 3 Stainless steel, 4 Galvanized steel, 5 Fiberglass, 6 Concrete tile, 7 PVC, 8 RMP (SR), 9 ABS, 10 Asbestos-cement, 11 Other (specify), 12 None used (open hole). SCREEN OR PERFORATION OPENINGS ARE: 1 Continuous slot, 2 Louvered shutter, 3 Mill slot, 4 Key punched, 5 Gauzed wrapped, 6 Wire wrapped, 7 Torch cut, 8 Saw cut, 9 Drilled holes, 10 Other (specify), 11 None (open hole). SCREEN-PERFORATED INTERVALS: From 15 ft. to 30 ft., From ... ft. to ... ft., From ... ft. to ... ft. GRAVEL PACK INTERVALS: From 13 ft. to 30 ft., From ... ft. to ... ft., From ... ft. to ... ft.

6 GROUT MATERIAL: 1 Neat cement, 2 Cement grout, 3 Bentonite, 4 Other Concrete. Grout Intervals: From 0 ft. to 1 ft., From 1 ft. to 13 ft., From ... ft. to ... ft. What is the nearest source of possible contamination: 1 Septic tank, 2 Sewer lines, 3 Watertight sewer lines, 4 Lateral lines, 5 Cess pool, 6 Seepage pit, 7 Pit privy, 8 Sewage lagoon, 9 Feedyard, 10 Livestock pens, 11 Fuel storage, 12 Fertilizer storage, 13 Insecticide storage, 14 Abandoned water well, 15 Oil well/Gas well, 16 Other (specify below). Direction from well? How many feet?

Table with columns FROM, TO, LITHOLOGIC LOG, FROM, TO, PLUGGING INTERVALS. Rows include: 0-4 Clay, v. moist, v. plastic, no odor, Dark Brown; 4-13 Clay, sl. silty, moist, plastic, no odor, Brown; 13-17 Clay, silty, moist, sl. stiff, no odor, Lt. Brown t; 17-30 Shale, moist, weathered, no odor, Lt. Gray mo. Additional text at bottom: MW1/SB1, Tag # 0041626, Flushmount; Project Name: OK Oil Service; GeoCore # 1362, KDHE # U6 083 12639

7 CONTRACTOR'S OR LANDOWNER'S CERTIFICATION: This water well was (1) constructed, (2) reconstructed, or (3) plugged under my jurisdiction and was completed on (mo/day/year) 5/7/2007 and this record is true to the best of my knowledge and belief. Kansas Water Well Contractor's License No. 527. This Water Well Record was completed on (mo/day/yr) 6/1/2007 under the business name of GeoCore, Inc. by (signature) Dale Kelt