

1 LOCATION OF WATER WELL: Fraction NW 1/4 NW 1/4 NW 1/4 Section Number 36 Township Number T 17 S Range Number R 16 E/W


Distance and direction from nearest town or city street address of well if located within city?
 231 N. Main, Otis

2 WATER WELL OWNER: OK Oil Service

RR#, St. Address, Box # : PO Box 349
 City, State, ZIP Code : Otis, Kansas 67565

Board of Agriculture, Division of Water Resources
 Application Number:

3 LOCATE WELL'S LOCATION WITH AN "X" IN SECTION BOX:

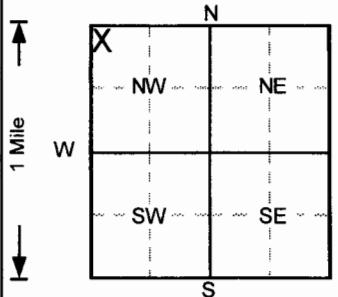

4 DEPTH OF COMPLETED WELL 30 ft. ELEVATION: 2035.61
 Depth(s) Groundwater Encountered 1. ft. 2. ft. 3. ft.
 WELL'S STATIC WATER LEVEL ... 19.23 ... ft. below land surface measured on mo/day/yr ... 5/10/2007 ...
 Pump test data: Well water was ... NA ... ft. after hours pumping gpm
 Est. Yield ... NA ... gpm: Well water was ft. after hours pumping gpm
 Bore Hole Diameter ... 8 ... in. to ... 30 ... ft., and ... in. to ... ft.
 WELL WATER TO BE USED AS: 5 Public water supply 8 Air conditioning 11 Injection well
 1 Domestic 3 Feedlot 6 Oil field water supply 9 Dewatering 12 Other (Specify below)
 2 Irrigation 4 Industrial 7 Lawn and garden only 10 Monitoring well
 Was a chemical/bacteriological sample submitted to Department? Yes.....No✓ ; If yes, mo/day/yr sample was submitted
 Water Well Disinfected? Yes No ✓

5 TYPE OF BLANK CASING USED: 5 Wrought iron 8 Concrete tile CASING JOINTS: Glued Clamped
 1 Steel 3 RMP (SR) 6 Asbestos-Cement 9 Other (specify below) Welded
 2 PVC 4 ABS 7 Fiberglass Threaded. ✓
 Blank casing diameter 2 in. to 15 ft. Dia in. to ft. Dia in. to ft.
 Casing height above land surface -6.72 in., weight lbs./ft. Wall thickness or gauge No. ... Sch. 40 ...
 TYPE OF SCREEN OR PERFORATION MATERIAL 7 PVC 10 Asbestos-cement
 1 Steel 3 Stainless steel 5 Fiberglass 8 RMP (SR) 11 Other (specify)
 2 Brass 4 Galvanized steel 6 Concrete tile 9 ABS 12 None used (open hole)
 SCREEN OR PERFORATION OPENINGS ARE: 5 Gauzed wrapped 8 Saw cut 11 None (open hole)
 1 Continuous slot 3 Mill slot 6 Wire wrapped 9 Drilled holes
 2 Louvered shutter 4 Key punched 7 Torch cut 10 Other (specify)
 SCREEN-PERFORATED INTERVALS: From 15 ft. to 30 ft., From ft. to ft.
 From ft. to ft., From ft. to ft.
 GRAVEL PACK INTERVALS: From 13 ft. to 30 ft., From ft. to ft.
 From ft. to ft., From ft. to ft.

6 GROUT MATERIAL: 1 Neat cement 2 Cement grout 3 Bentonite 4 Other Concrete
 Grout intervals: From 0 ft. to 1 ft., From 1 ft. to 13 ft., From ft. to ft.
 What is the nearest source of possible contamination: 10 Livestock pens 14 Abandoned water well
 1 Septic tank 4 Lateral lines 7 Pit privy 11 Fuel storage 15 Oil well/Gas well
 2 Sewer lines 5 Cess pool 8 Sewage lagoon 12 Fertilizer storage 16 Other (specify below)
 3 Watertight sewer lines 6 Seepage pit 9 Feedyard 13 Insecticide storage
 Direction from well? How many feet?

FROM	TO	LITHOLOGIC LOG	FROM	TO	PLUGGING INTERVALS
0	4	Clay, moist, plastic, no odor, Dark Brown			
4	18	Clay, silty, moist, plastic, no odor, Brown			
18	23	Clay, sl. silty, saturated stringers, mod. odor,			
23	30	Clay, weathered shale, v. moist, Yellow			

MW4/SB4 , Tag # 0041629 , Flushmount
 Project Name: OK Oil Service
 GeoCore # 1362 , KDHE # U6 083 12639

7 CONTRACTOR'S OR LANDOWNER'S CERTIFICATION: This water well was (1) constructed, (2) reconstructed, or (3) plugged under my jurisdiction and was completed on (mo/day/year) 5/8/2007 and this record is true to the best of my knowledge and belief.
 Kansas Water Well Contractor's License No. ... 527 ... This Water Well Record was completed on (mo/day/yr) 5/11/07
 under the business name of GeoCore, Inc. by (signature) Dale Bell