


1 LOCATION OF WATER WELL: Fraction Section Number Township Number Range Number
County: Rush SE 1/4 SE 1/4 SE 1/4 26 T 17 S R 16 E W

Distance and direction from nearest town or city street address of well if located within city?
~120'W of corner of Diel Ave. & Main St.

2 WATER WELL OWNER: OK Oil Service
RR#, St. Address, Box #: PO Box 349
City, State, ZIP Code: Otis, Kansas 67565
Board of Agriculture, Division of Water Resources
Application Number:

3 LOCATE WELL'S LOCATION WITH AN "X" IN SECTION BOX:
4 DEPTH OF COMPLETED WELL: 25 ft. ELEVATION: 2035.72
WELL'S STATIC WATER LEVEL: 17.82 ft. below land surface measured on 10/23/2008
Pump test data: Well water was NA ft. after hours pumping gpm
Est. Yield: NA gpm: Well water was ft. after hours pumping gpm
Bore Hole Diameter: 8 in. to 25 ft., and in. to ft.
WELL WATER TO BE USED AS: 10 Monitoring well
Water Well Disinfected? Yes No

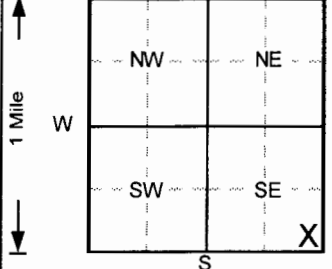

5 TYPE OF BLANK CASING USED: 2 PVC, 7 PVC
Blank casing diameter: 2 in. to 15 ft., Dia in. to ft., Dia in. to ft.
Casing height above land surface: -6.24 in., weight lbs./ft. Wall thickness or gauge No. Sch. 40
TYPE OF SCREEN OR PERFORATION MATERIAL: 7 PVC, 10 Asbestos-cement
SCREEN OR PERFORATION OPENINGS ARE: 3 Mill slot, 10 Other (specify)
SCREEN-PERFORATED INTERVALS: From 15 ft. to 25 ft., From ft. to ft.
GRAVEL PACK INTERVALS: From 13 ft. to 25 ft., From ft. to ft.

6 GROUT MATERIAL: 1 Neat cement, 3 Bentonite
Grout intervals: From 0 ft. to 1 ft., From 1 ft. to 13 ft., From ft. to ft.
What is the nearest source of possible contamination: 10 Livestock pens, 14 Abandoned water well
Direction from well? How many feet?

LITHOLOGIC LOG and PLUGGING INTERVALS table with columns FROM, TO, LITHOLOGIC LOG, FROM, TO, PLUGGING INTERVALS.

7 CONTRACTOR'S OR LANDOWNER'S CERTIFICATION: This water well was (1) constructed, (2) reconstructed, or (3) plugged under my jurisdiction and was completed on (mo/day/year) 10/9/2008 and this record is true to the best of my knowledge and belief.
Kansas Water Well Contractor's License No. 527 This Water Well Record was completed on (mo/day/yr) 10/22/08
under the business name of GeoCore, Inc. by (signature) Doe Well