


1 LOCATION OF WATER WELL: County: Rush Fraction NE 1/4 NE 1/4 NE 1/4 Section Number 35 Township Number T 17 S Range Number R 16 EW

Distance and direction from nearest town or city street address of well if located within city? SE corner Diel & 4th St., Otis

2 WATER WELL OWNER: OK Oil Service RR#, St. Address, Box #: PO Box 349 City, State, ZIP Code: Otis, Kansas 67565 Board of Agriculture, Division of Water Resources Application Number:

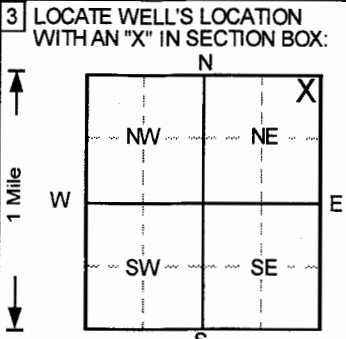

3 LOCATE WELL'S LOCATION WITH AN 'X' IN SECTION BOX: 4 DEPTH OF COMPLETED WELL: 25 ft. ELEVATION: 2037.05. WELL'S STATIC WATER LEVEL: 20.3 ft. below land surface measured on 9/24/2009. Pump test data: Well water was NA ft. after NA hours pumping NA gpm. Est. Yield NA gpm. Bore Hole Diameter 8 in. to 25 ft. WELL WATER TO BE USED AS: 10 Monitoring well. Was a chemical/bacteriological sample submitted? No. Water Well Disinfected? No.

5 TYPE OF BLANK CASING USED: 2 PVC. Blank casing diameter 2 in. to 15 ft. Dia. Casing height above land surface -5.4 in., weight lbs./ft. Wall thickness or gauge No. Sch. 40. TYPE OF SCREEN OR PERFORATION MATERIAL: 7 PVC. SCREEN OR PERFORATION OPENINGS ARE: 3 Mill slot. SCREEN-PERFORATED INTERVALS: From 15 ft. to 25 ft. GRAVEL PACK INTERVALS: From 13 ft. to 25 ft.

6 GROUT MATERIAL: 2 Cement grout, 3 Bentonite. Grout Intervals: From 0 ft. to 1 ft., From 1 ft. to 13 ft. What is the nearest source of possible contamination: 10 Livestock pens, 14 Abandoned water well, 15 Oil well/Gas well, 16 Other (specify below).

Direction from well? FROM TO LITHOLOGIC LOG FROM TO PLUGGING INTERVALS. 0 5 Clay, silty, Dark Brown. 5 8 Clay, silty, Brown. 8 16 Clay, silty, Brown. 16 21 Clay, silty, Yellow Brown. 21 25 Clay, silty, Yellow Brown. MW26/SB30, Tag # 0044179, Flushmount.

7 CONTRACTOR'S OR LANDOWNER'S CERTIFICATION: This water well was (1) constructed, (2) reconstructed, or (3) plugged under my jurisdiction and was completed on (mo/day/year) 9/15/2009 and this record is true to the best of my knowledge and belief. Kansas Water Well Contractor's License No. 527. This Water Well Record was completed on (mo/day/yr) 9/30/2009 under the business name of GeoCore, Inc. by (signature) Dan Hall.