


1 LOCATION OF WATER WELL: County: Rush Fraction NE 1/4 NW 1/4 NW 1/4 Section Number 36 Township Number T 17 S Range Number R 16 EW

Distance and direction from nearest town or city street address of well if located within city? ~250' S of SE corner of Diel & 6th St., Otis

2 WATER WELL OWNER: OK Oil Service RR#, St. Address, Box #: PO Box 349 City, State, ZIP Code: Otis, Kansas 67565 Board of Agriculture, Division of Water Resources Application Number:

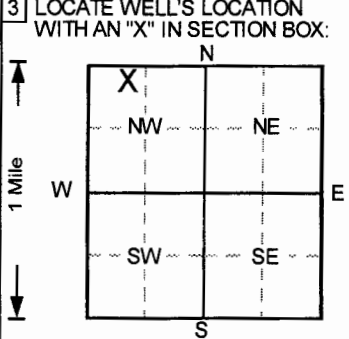

4 DEPTH OF COMPLETED WELL 23 ft ELEVATION: 2027.65 WELL'S STATIC WATER LEVEL 17.65 ft below land surface measured on mo/day/yr 9/24/2009 Pump test data: Well water was NA ft after ... hours pumping ... gpm Est. Yield NA gpm: Well water was ... ft after ... hours pumping ... gpm Bore Hole Diameter 8 in. to 23 ft, and ... in. to ... ft WELL WATER TO BE USED AS: 10 Monitoring well

5 TYPE OF BLANK CASING USED: 2 PVC 5 Wrought iron 8 Concrete tile CASING JOINTS: Glued Clamped Welded Threaded 7 PVC 10 Asbestos-cement SCREEN OR PERFORATION MATERIAL 7 PVC 10 Asbestos-cement SCREEN OR PERFORATION OPENINGS ARE: 3 Mill slot 5 Gauzed wrapped 8 Saw cut 11 None (open hole) SCREEN-PERFORATED INTERVALS: From 13 ft to 23 ft GRAVEL PACK INTERVALS: From 11 ft to 23 ft

6 GROUT MATERIAL: 2 Cement grout 3 Bentonite 4 Other Grout intervals: From 0 ft to 1 ft, From 1 ft to 11 ft What is the nearest source of possible contamination: 1 Septic tank 4 Lateral lines 7 Pit privy 10 Livestock pens 14 Abandoned water well

Table with columns FROM, TO, LITHOLOGIC LOG, FROM, TO, PLUGGING INTERVALS. Rows show clay layers from 0 to 23 feet depth.

7 CONTRACTOR'S OR LANDOWNER'S CERTIFICATION: This water well was (1) constructed, (2) reconstructed, or (3) plugged under my jurisdiction and was completed on (mo/day/year) 9/15/2009 and this record is true to the best of my knowledge and belief. Kansas Water Well Contractor's License No. 527 This Water Well Record was completed on (mo/day/yr) 9/30/2009 under the business name of GeoCore, Inc. by (signature) Dale Bell